


T.9 S. R.5 W. W. M.

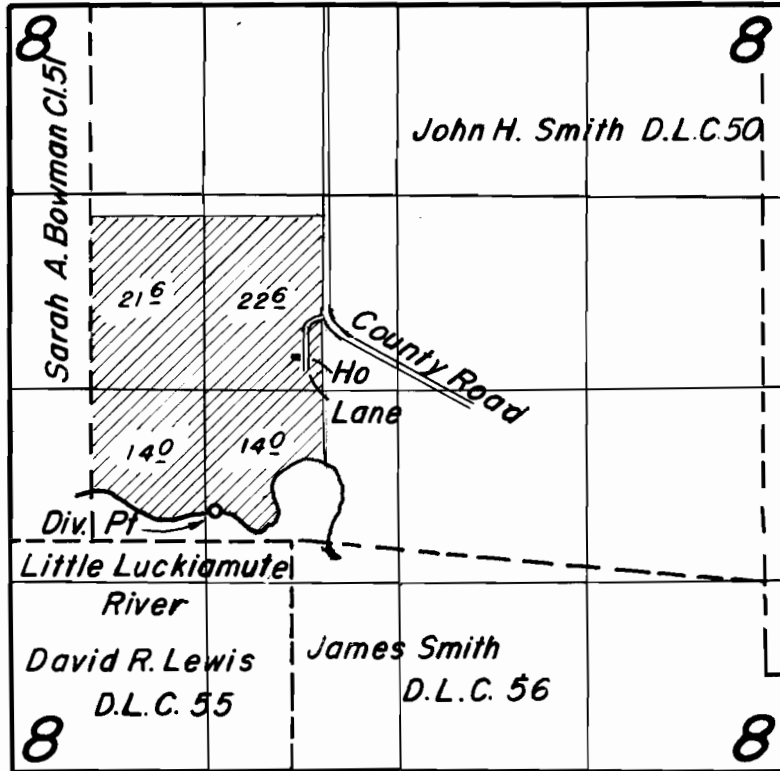

FINAL PROOF SURVEY
UNDER

Application No. 32347 Permit No. 25619
IN NAME OF

H. H. Ratzlaff

Surveyed Feb. 27 1963, by Floyd J. Siegmund