


T. 9 & 10 S. R. 4 W. W.M.

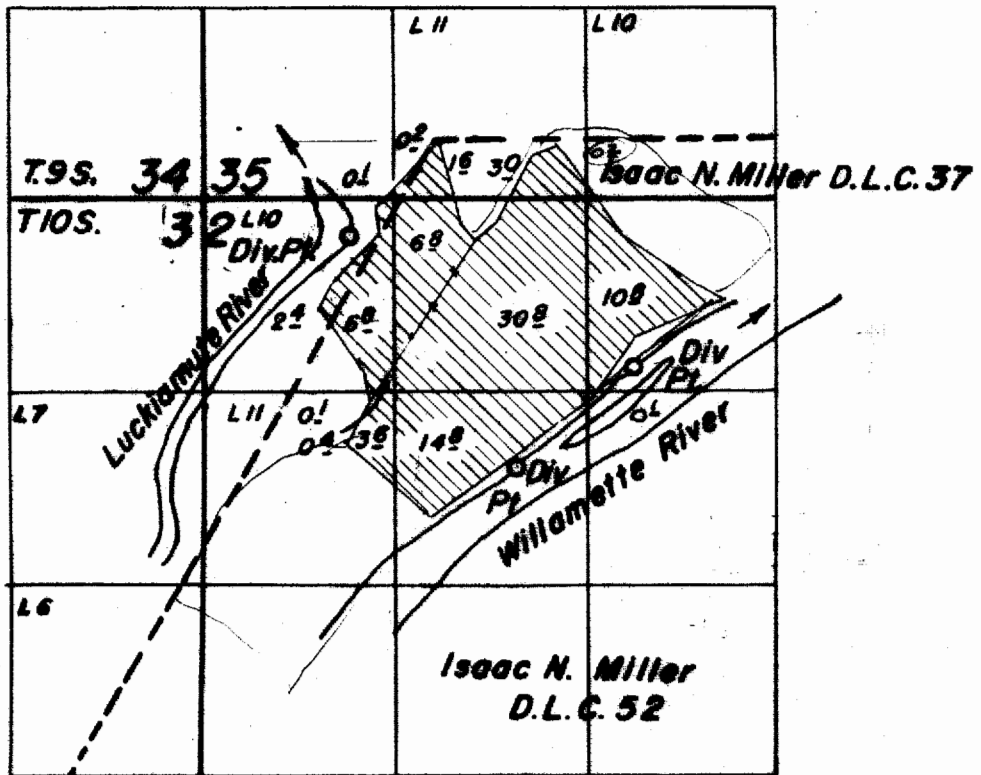

**FINAL PROOF SURVEY**  
UNDER

Application No. 32556 Permit No. 25777  
IN NAME OF

**Claude W. & Garnet F. Pilcher**

Surveyed March 7, 1963, by *Floyd L. Siegmund*