


T. 7 S. R. 4 W. W. M.

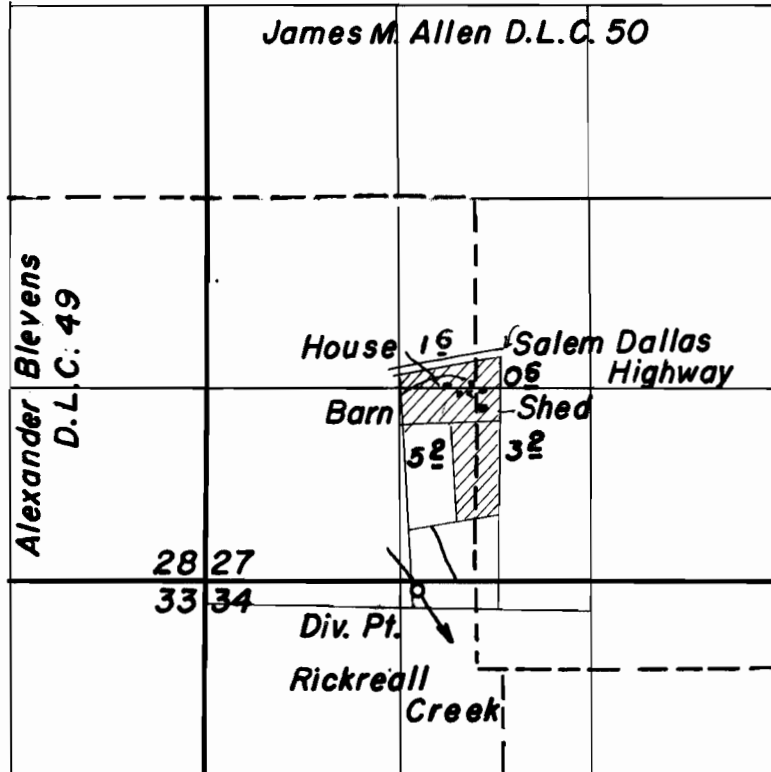

FINAL PROOF SURVEY
UNDER

Application No. 33257 Permit No. 26294
IN NAME OF

Leander & Frances Marie Quiring

Surveyed Feb 27 1963, by Floyd L. Siegmund