


T.8 & 9S.R.5W.W.M.

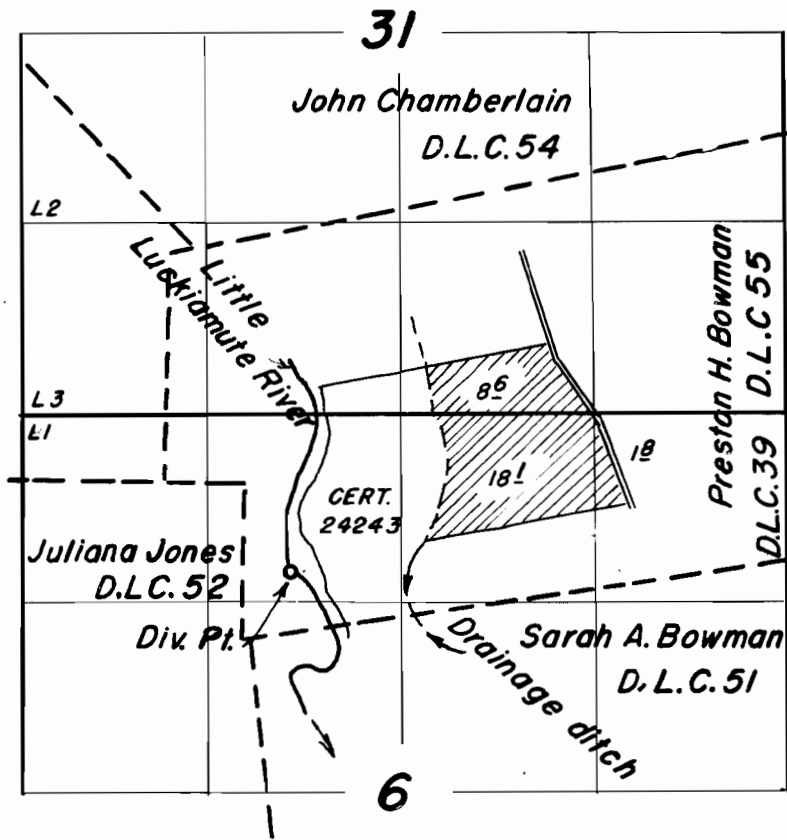

FINAL PROOF SURVEY
UNDER

Application No. 35036 Permit No. 27440
IN NAME OF

Clinton M. Ruitter

Surveyed March 11, 1963, by Floyd L. Siegmund