


**T. 8 S. R. 5 W. W.M.**

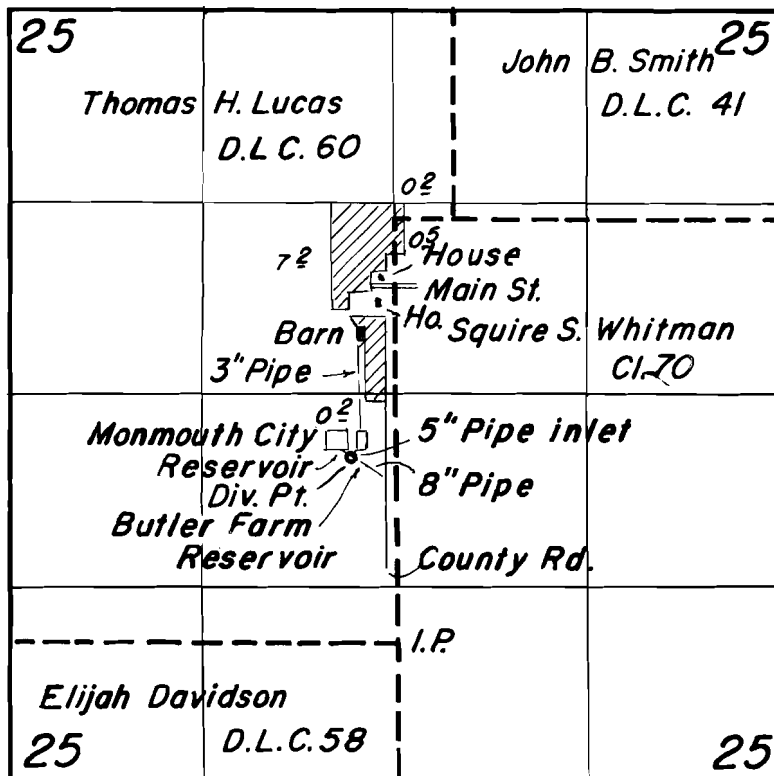

**FINAL PROOF SURVEY**  
 UNDER

R-36589                      R-2702  
 Application No. 36590      Permit No. 27702  
 IN NAME OF

Melford N. Nelson

Surveyed March 4 1963, by Floyd L. Sigmond