


T. 8 S. R. 5 W. W.M.

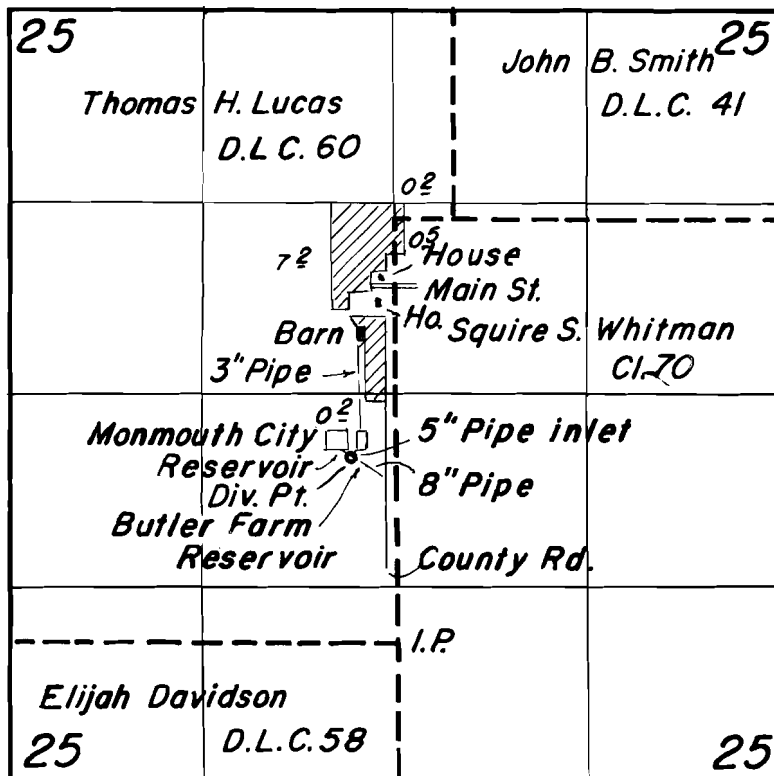

FINAL PROOF SURVEY
UNDER

R-36589 R-2702
 Application No. 36590 Permit No. 27702
 IN NAME OF

Melford N. Nelson

Surveyed March 4 1963, by Floyd L. Sigmond