


T.9S. R.4W.W.M.

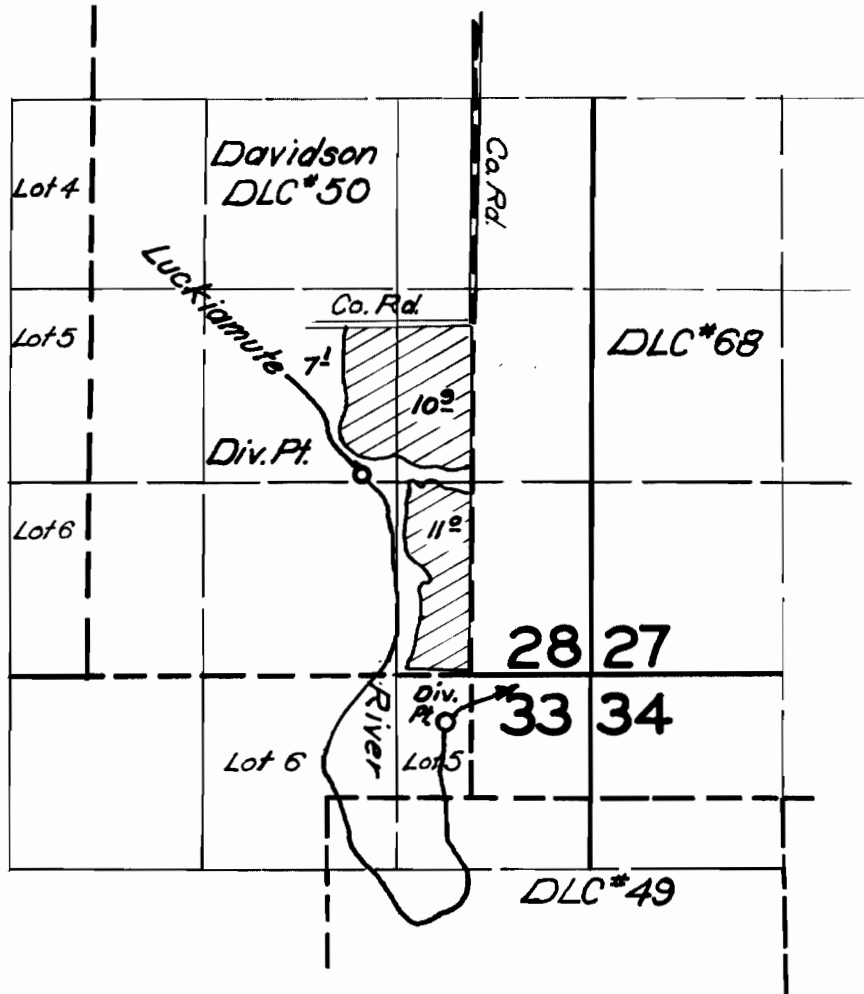

FINAL PROOF SURVEY  
UNDER

Application No. 37331 Permit No. 27808  
IN NAME OF

*Warner and Linn*

Surveyed 2 July 1962, by *Carl R. Baker*