


T. 9 S. R. 6 W. W.M.

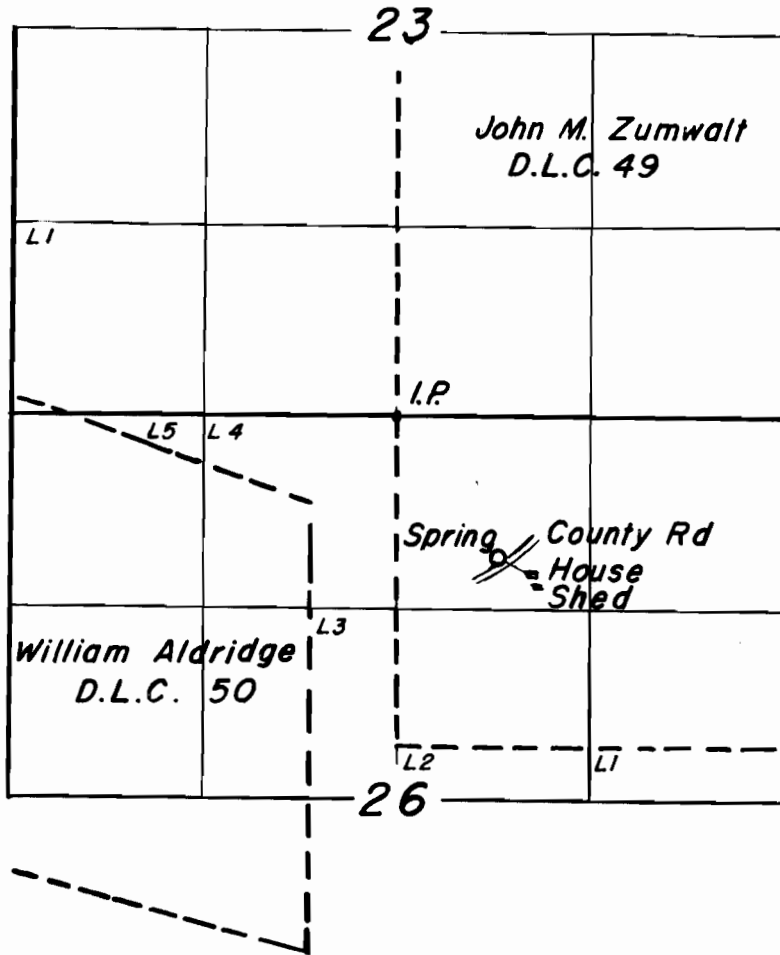

FINAL PROOF SURVEY
UNDER

Application No. 37762 Permit No. 28137
IN NAME OF

Herman Amos

Surveyed March 5 1963 by Floyd L. Siegmund