


T. 8 S. R. 6 W. W. M.

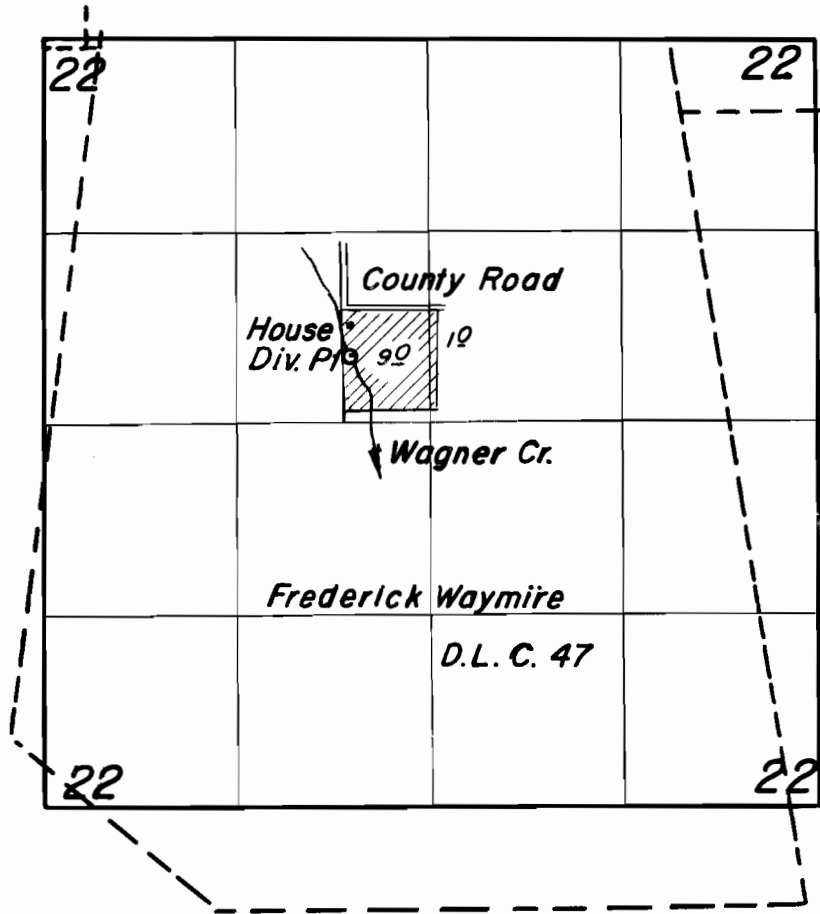

FINAL PROOF SURVEY
UNDER

Application No. 37920 Permit No. 28243
IN NAME OF

Edward Bakke

Surveyed March 5 1963 by Floyd L. Siegmund