


T. I. S. R. 9 W. W. M.

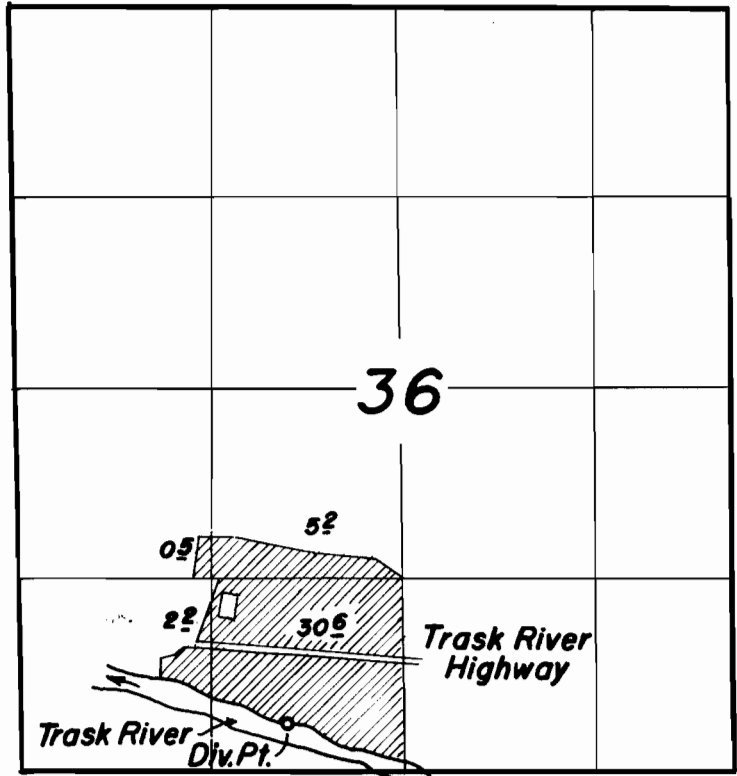

**FINAL PROOF SURVEY
UNDER**

Application No. 37666 Permit No. 28075
IN NAME OF

Dale C. Turner

Surveyed July 30, 1963 by C. Baker