


T.6N.R.35&36E.W.M.

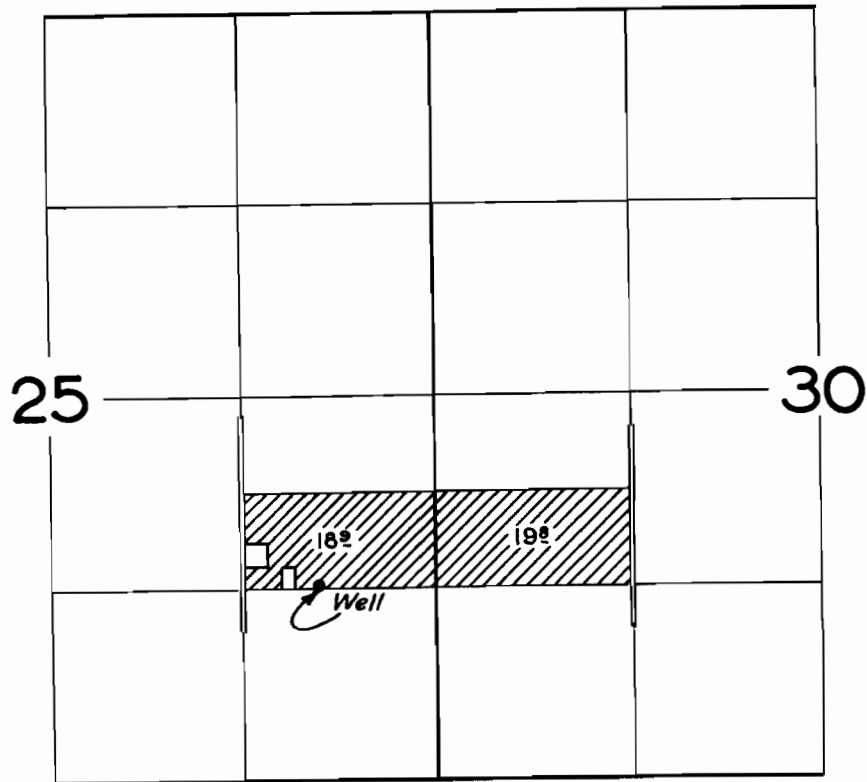

**FINAL PROOF SURVEY**  
UNDER

Application No. G-1052 Permit No. G-1025  
IN NAME OF

SAMUEL CUMMINGS

Surveyed May 3, 1962, by [Signature]