


T. 1 N. R. 13 E. W. M.

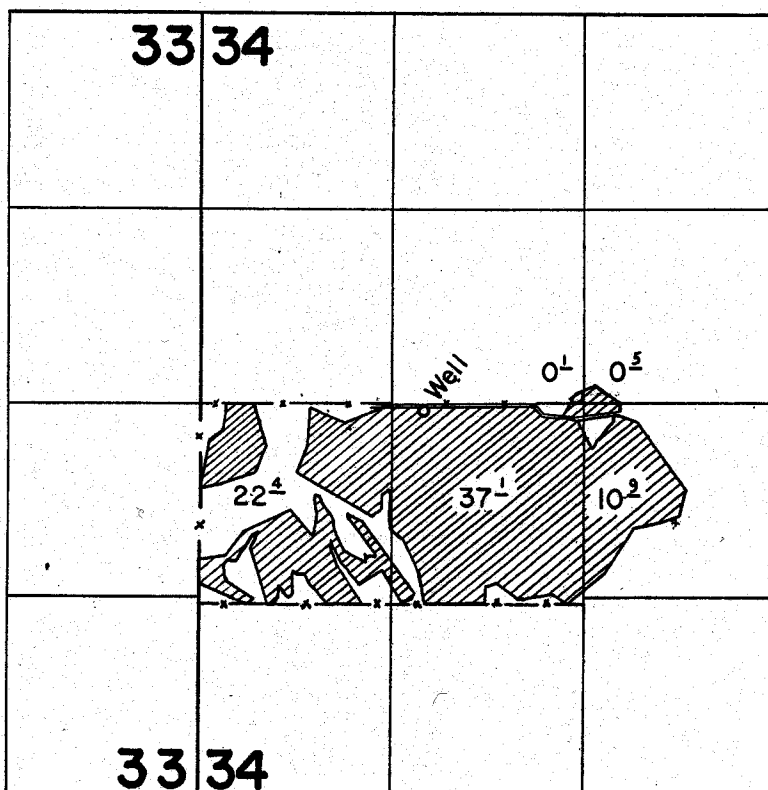

FINAL PROOF SURVEY UNDER

Application No. G-1354. Permit No. G-1233.
IN NAME OF

Surveyed June 7, 1962, by *L. W. Gebousek*