


T. 1 N. R. 12 E. W.M.

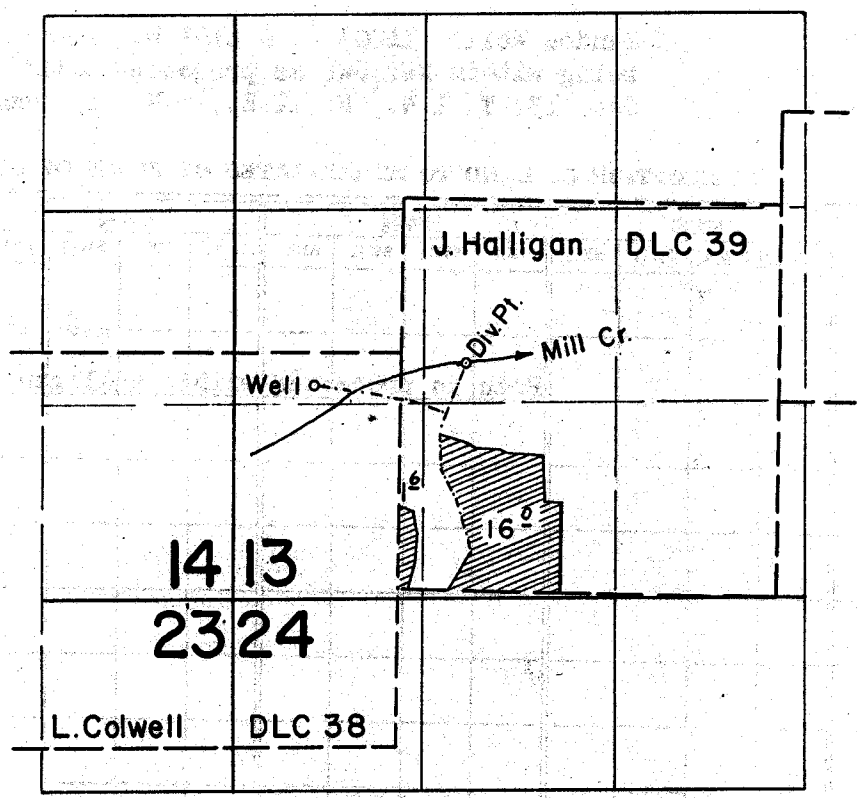

FINAL PROOF SURVEY UNDER

Transfer No. S-138
Application No. G-1457... Permit No. G-1367.
IN NAME OF

CHARLES J. SANDOZ

Surveyed April 6, 1962, by *P.W. Jelenc*