


T. 12 S. R. 24 E. W. M.

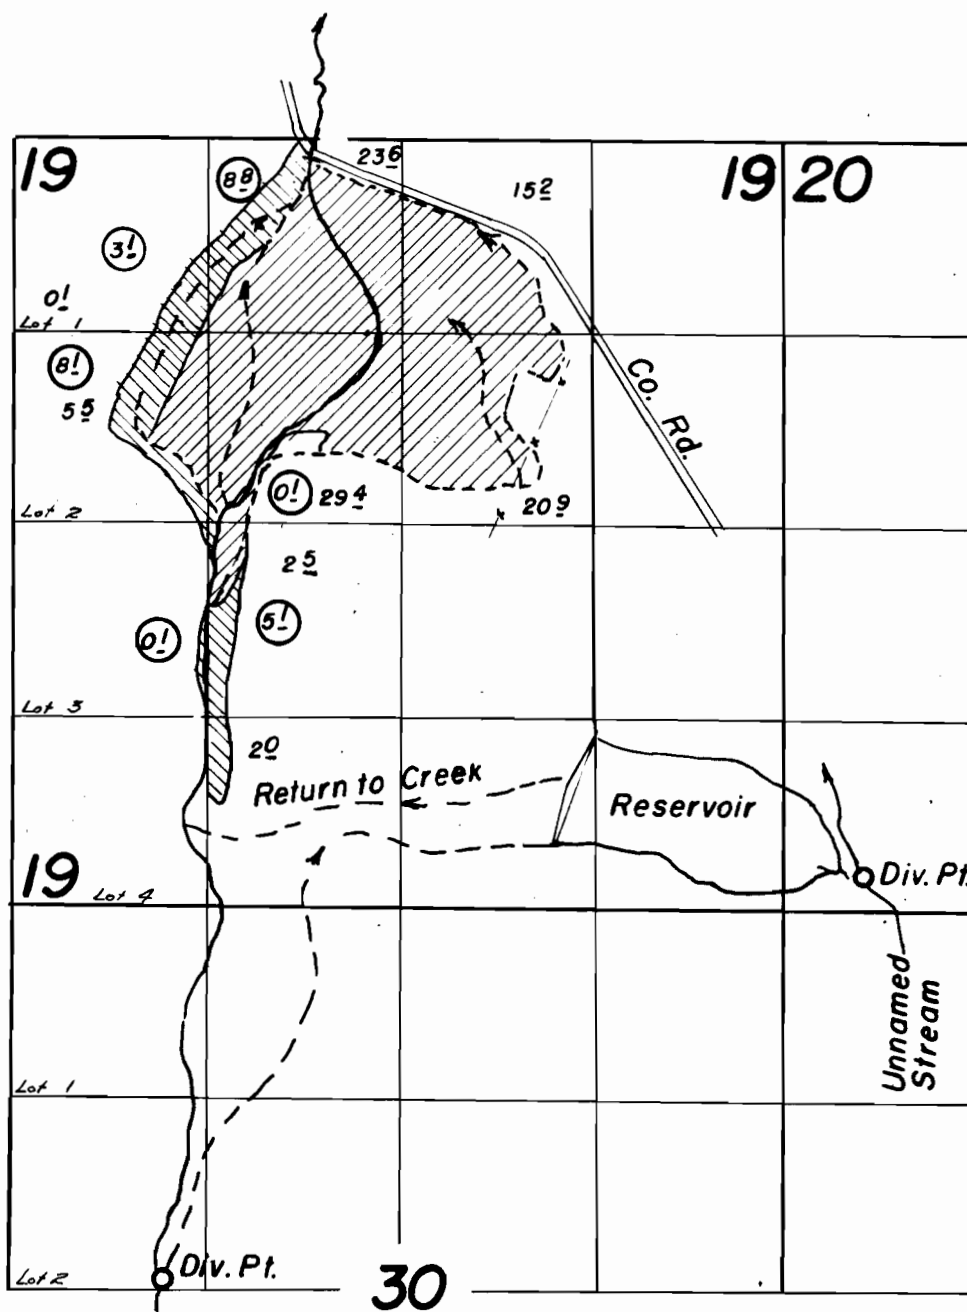

Fort Creek **FINAL PROOF SURVEY**
UNDER

 Primary (69)
 Supplemental

R-26030 R-1220
Application No. 26031... Permit No. 20597...
IN NAME OF

E.E. Krupke

Surveyed Oct. 1, 1963, by Ralph Jackson