


T. 12 S. R. 24 E. W.M.

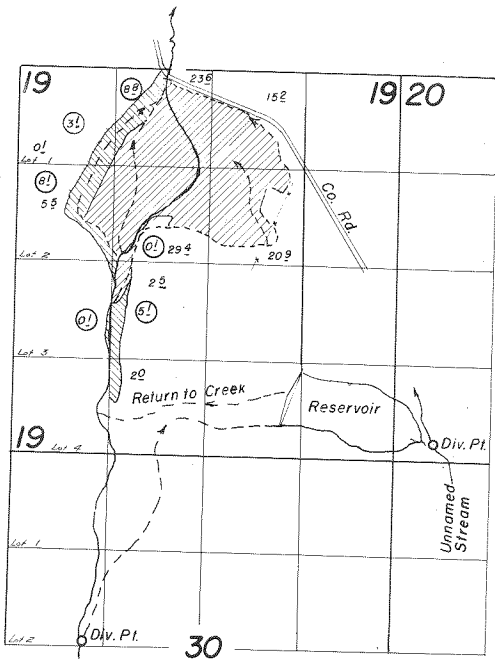

Fort Creek **FINAL PROOF SURVEY**
UNDER

 Primary (00)

 Supplemental

R-26030 R-1220
Application No. 26031 Permit No. 20597
IN NAME OF

E.E. Krupke

Surveyed Oct. 1 1963, by Ralph Jackson