


T. 35S.R.6-7W.W.M.

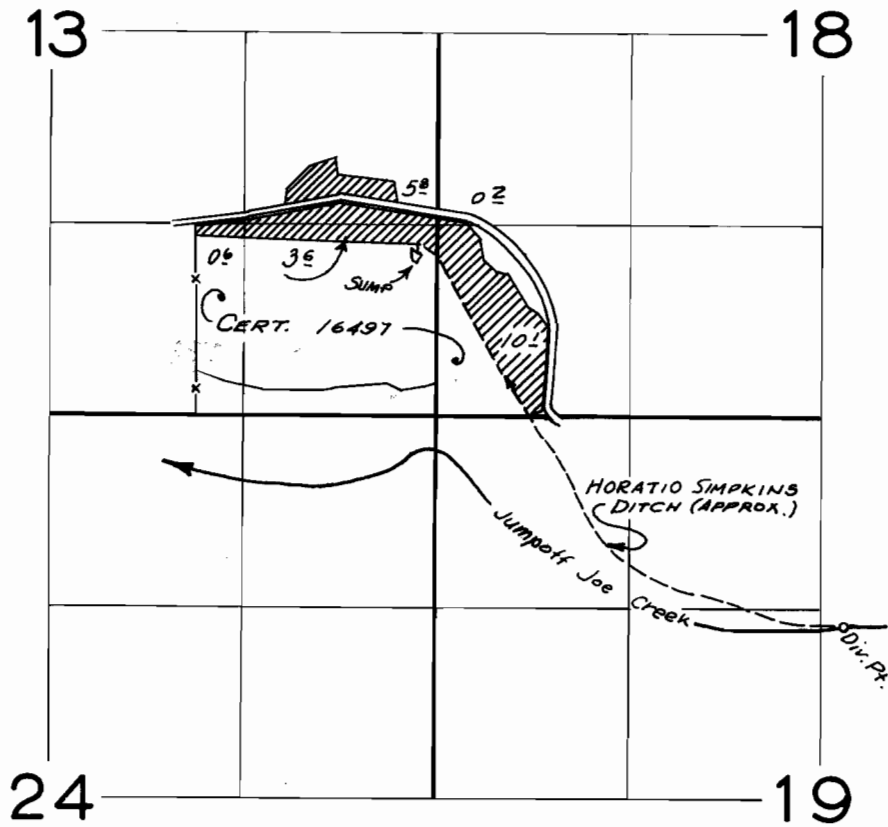

**FINAL PROOF SURVEY**  
UNDER

Application No. 29.291. Permit No. 23025.  
IN NAME OF

CONRAD O. NYSTROM

Surveyed July 22 1959, by R. Jackson