


T.28 & 29 S. R. 12 & 13 W. W.M.

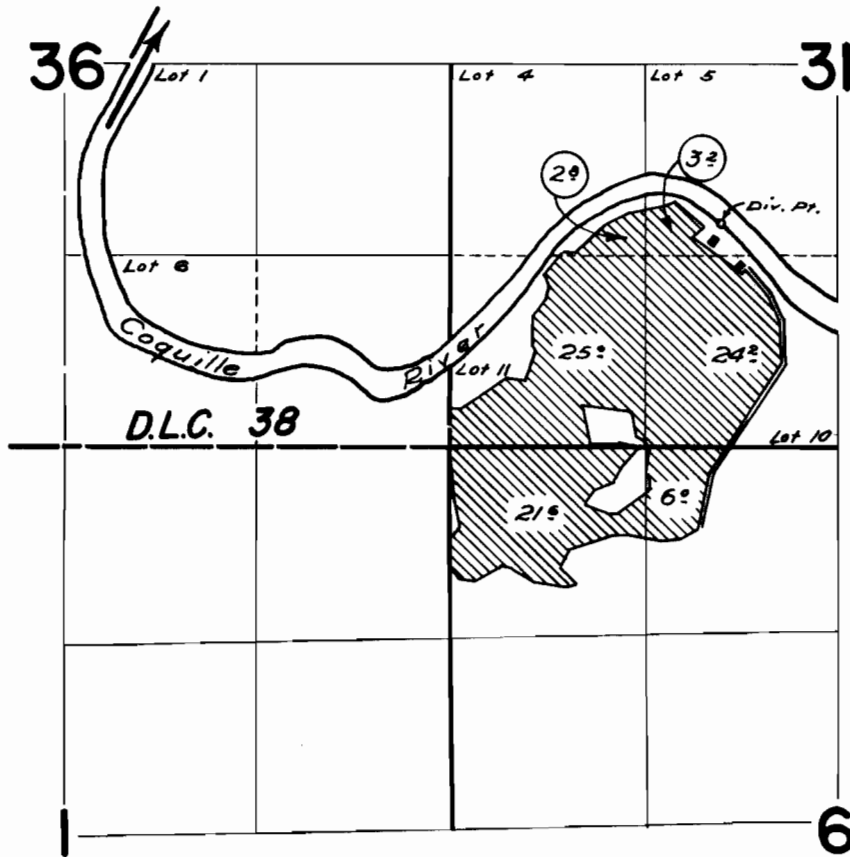

FINAL PROOF SURVEY
UNDER

Application No. 30678. Permit No. 24215.....
IN NAME OF

MRS. SARAH A. McCLOSKEY

Surveyed August 10 1901., by C. O. Bartels.