


T.39S., R.43E.W.M.

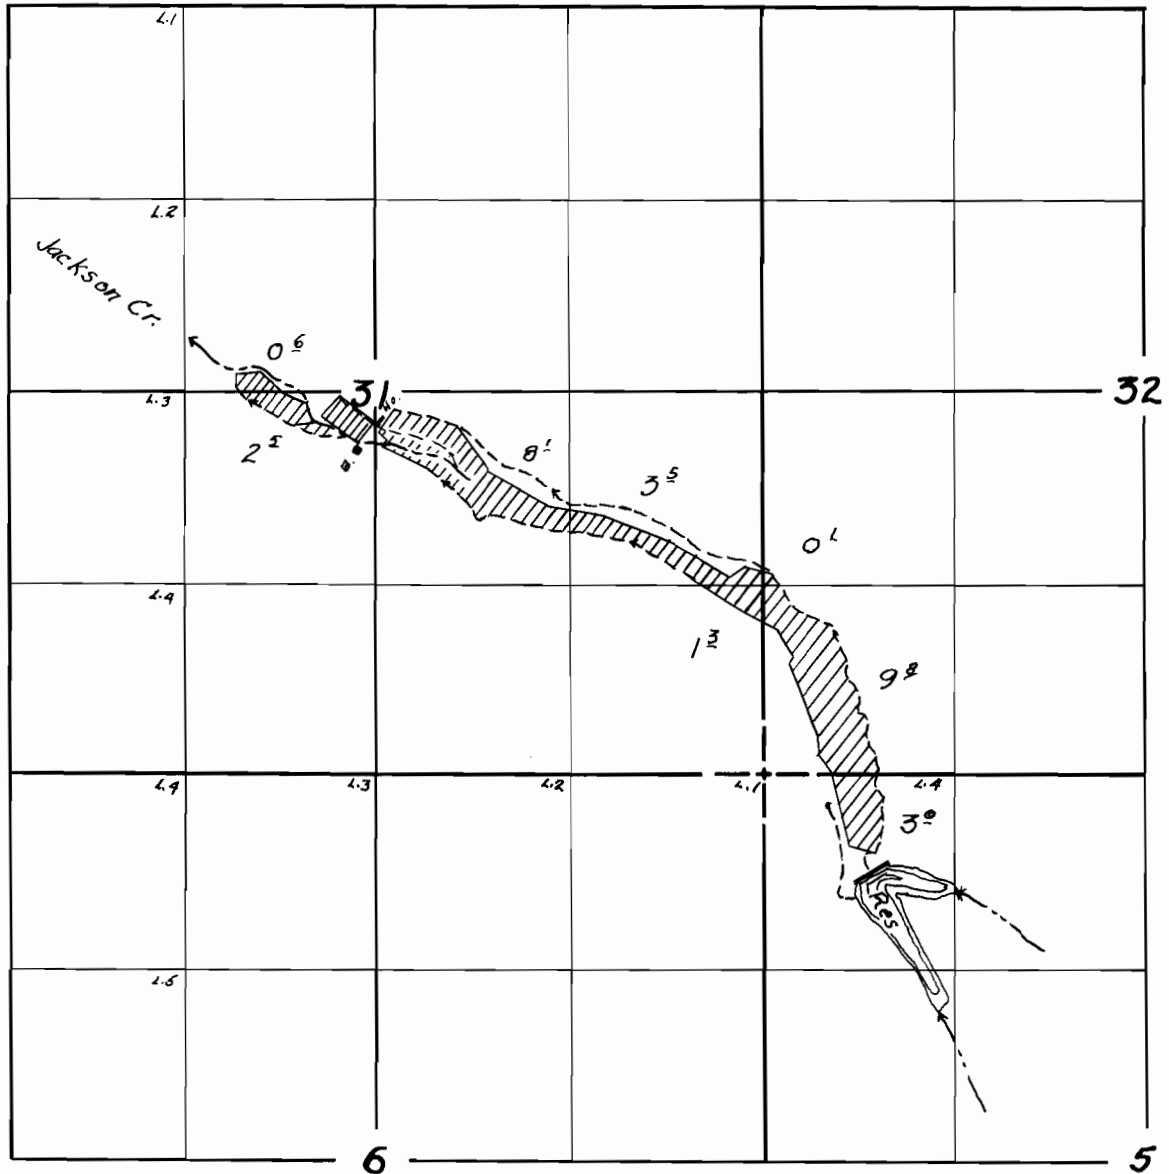

FINAL PROOF SURVEY

UNDER

R-22306

R-871

Application No. 22308 Permit No. 17591

IN NAME OF

MARGE BENGDA ECHAVE

Surveyed 6 & 7 Nov. 1955, by *Robert D. Burt*