


T. 32&33 S.R. 45 E.W.M.

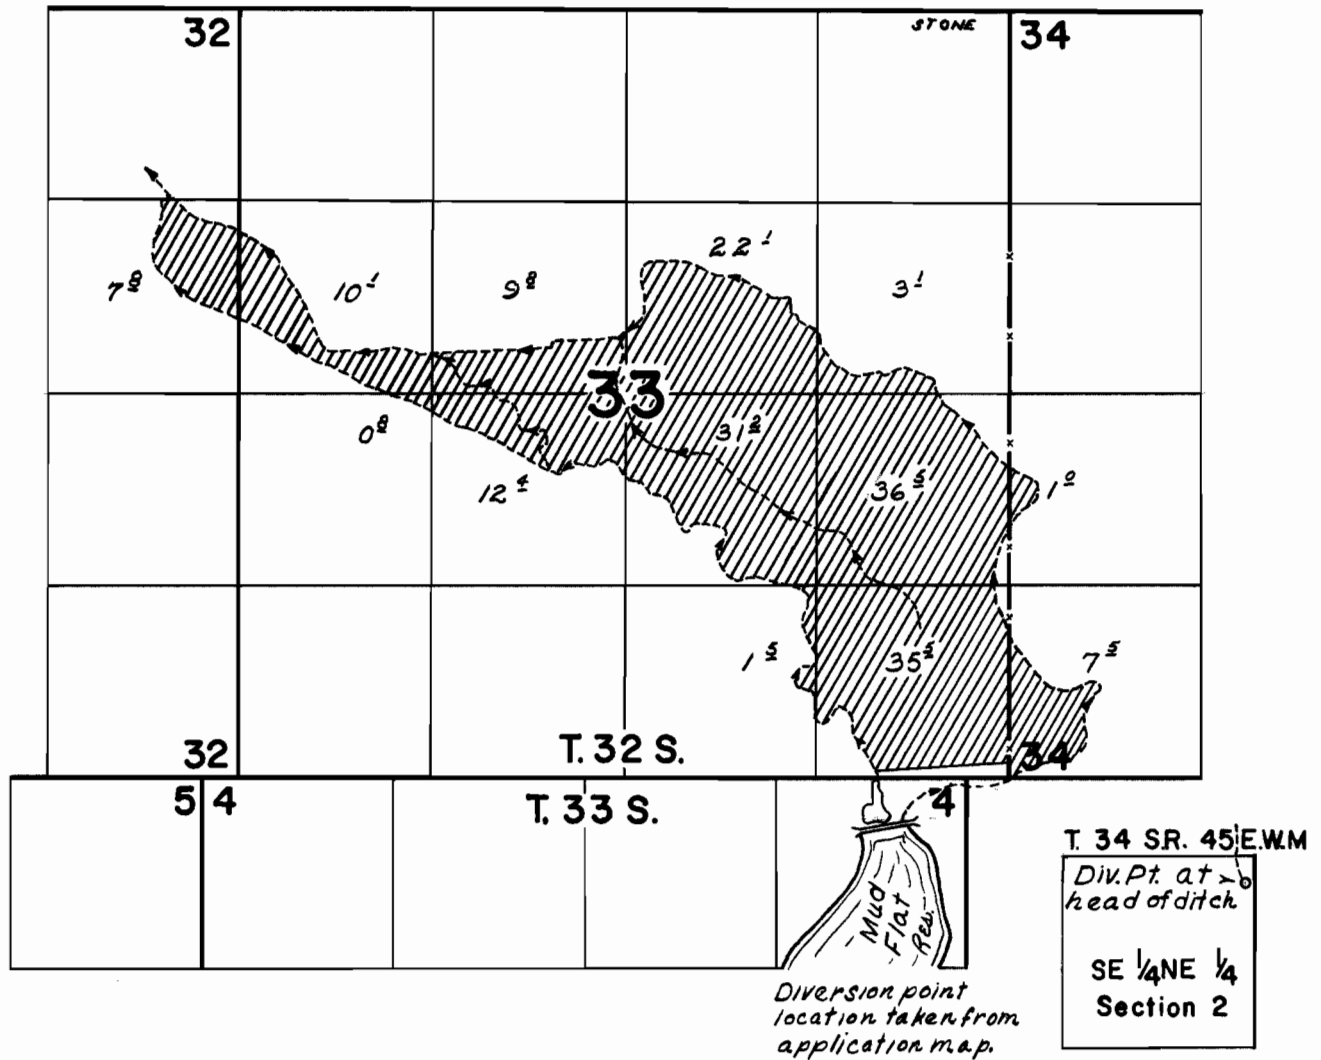

FINAL PROOF SURVEY UNDER

R-30890 R-1947
Application No. 30892 Permit No. 24536
IN NAME OF

JOAQUIN & FELIX JACA

Surveyed July 17, 1962, by C.R. Baker