


T.8S.R.40E.W.M.

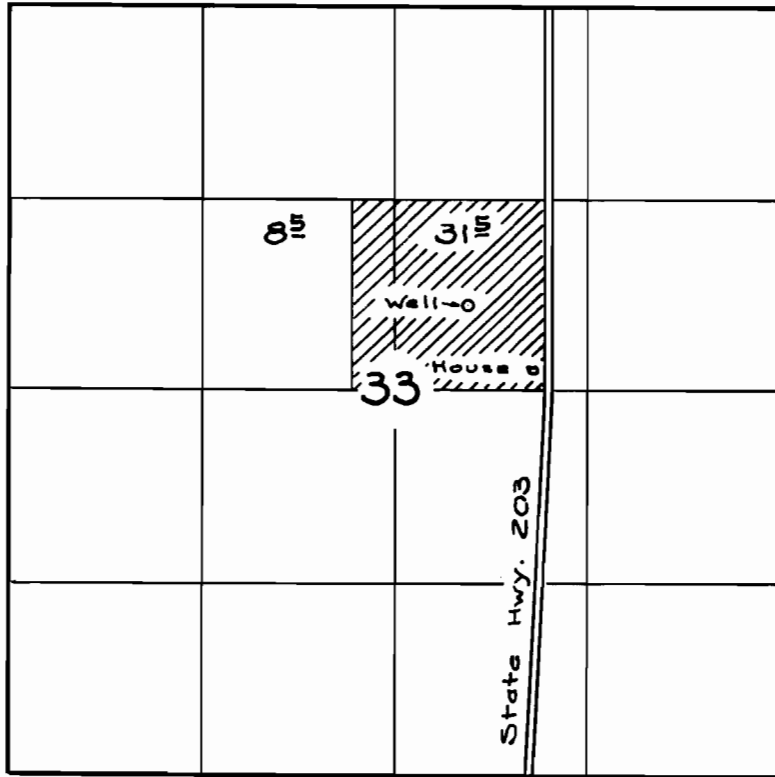

FINAL PROOF SURVEY
UNDER

Application No. G-2102 Permit No. G-1933
IN NAME OF

FRANCIS & POWERS

Surveyed Dec. 2, 1963, by D.B. Hall