


# T. 7S. R. 38E. W.M.

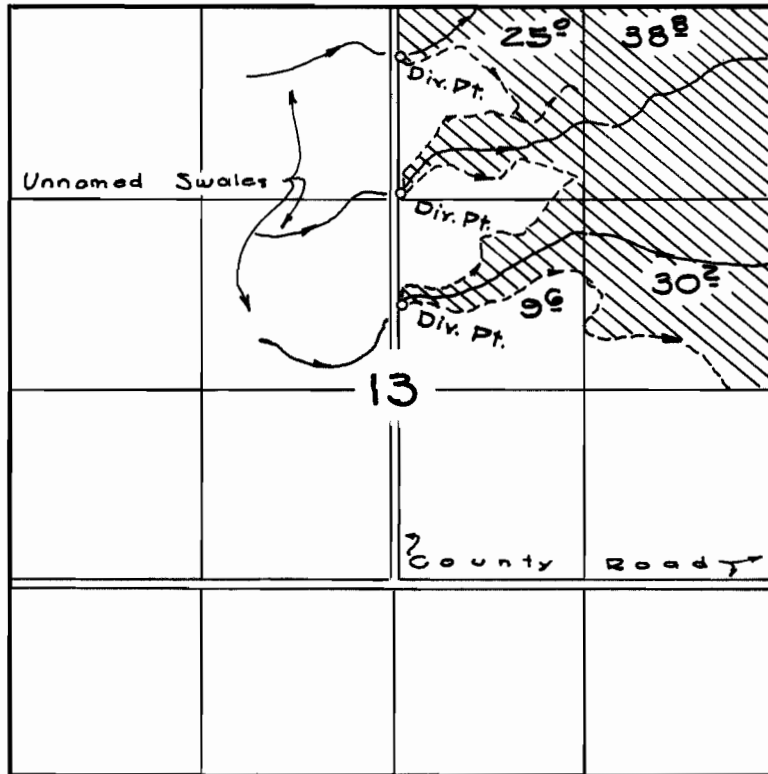

## FINAL PROOF SURVEY UNDER

Application No. 37970 Permit No. 28314  
IN NAME OF

L. W. PERKINS

Surveyed Nov. 21, 1963, by D. B. Hall