


T.8S. R.39E.W.M.

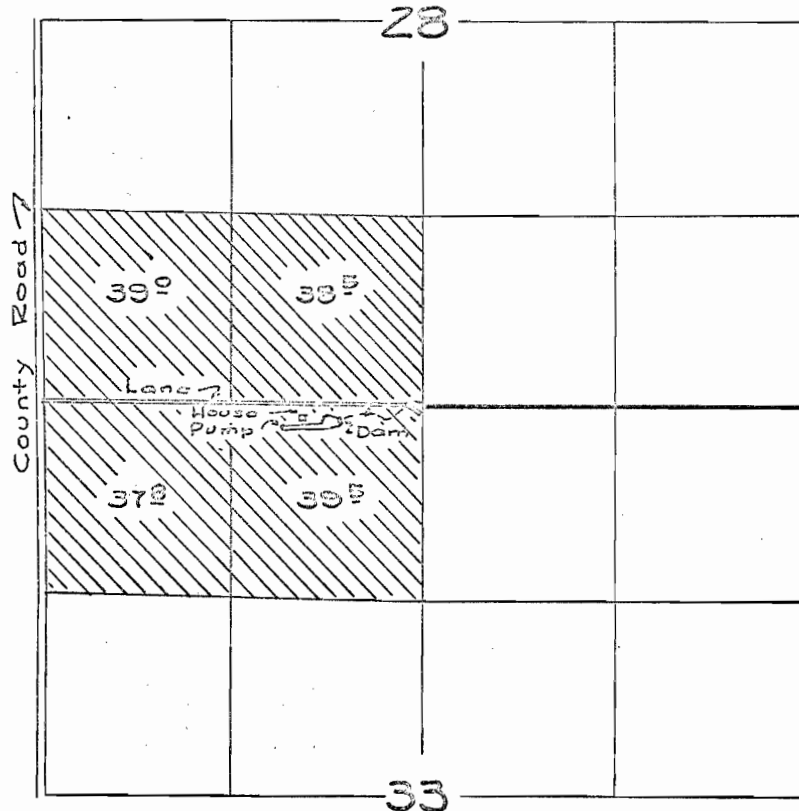

FINAL PROOF SURVEY
UNDER

Application No. 37704 Permit No. 28422
IN NAME OF

MARIE DE VOS

Surveyed Oct. 30, 1963, by D.S. Hall