


T.8S. R.39E.W.M.

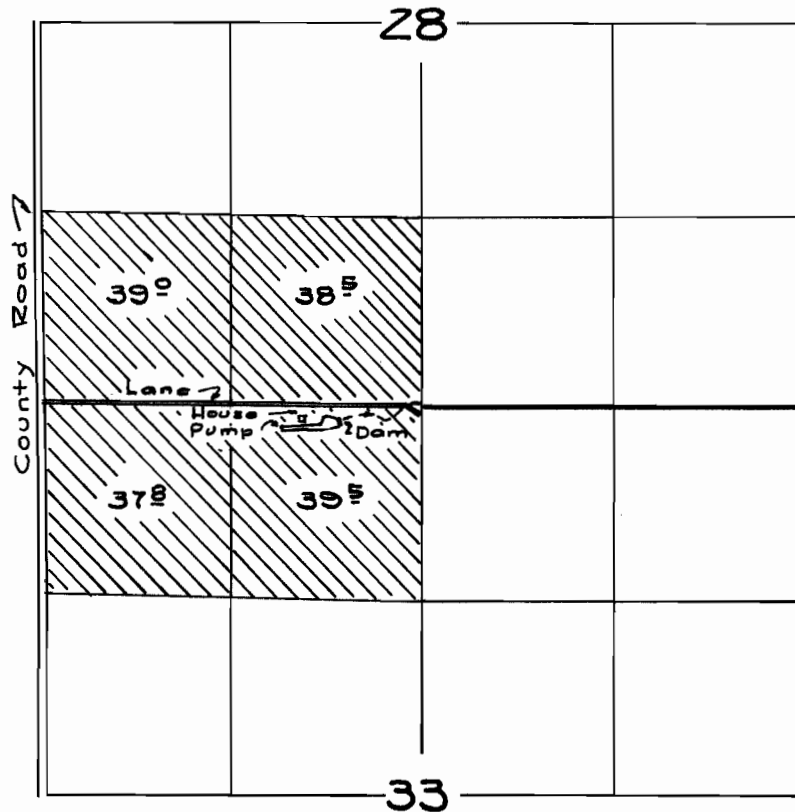

**FINAL PROOF SURVEY**  
UNDER

Application No. 37704 Permit No. 28422  
IN NAME OF

MAZIE DE VOS

Surveyed Oct. 30 1963, by D.B. Hall