


# T.I.S.R.4 W.W.M.

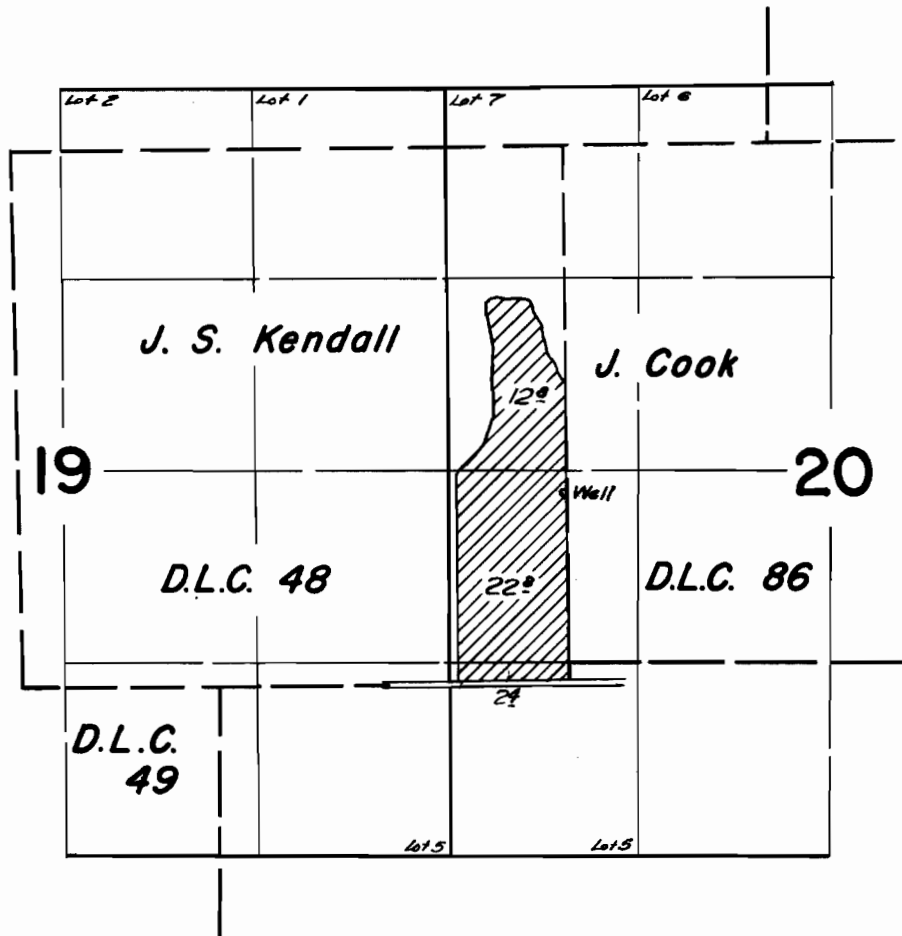

## FINAL PROOF SURVEY UNDER

Application No. **G-2358** Permit No. **G-2176**  
IN NAME OF

**WILBUR SHAW**

Surveyed Nov. 13, 1963, by *A. Jackson*