


T.II.S.R.4&5W.W.M.

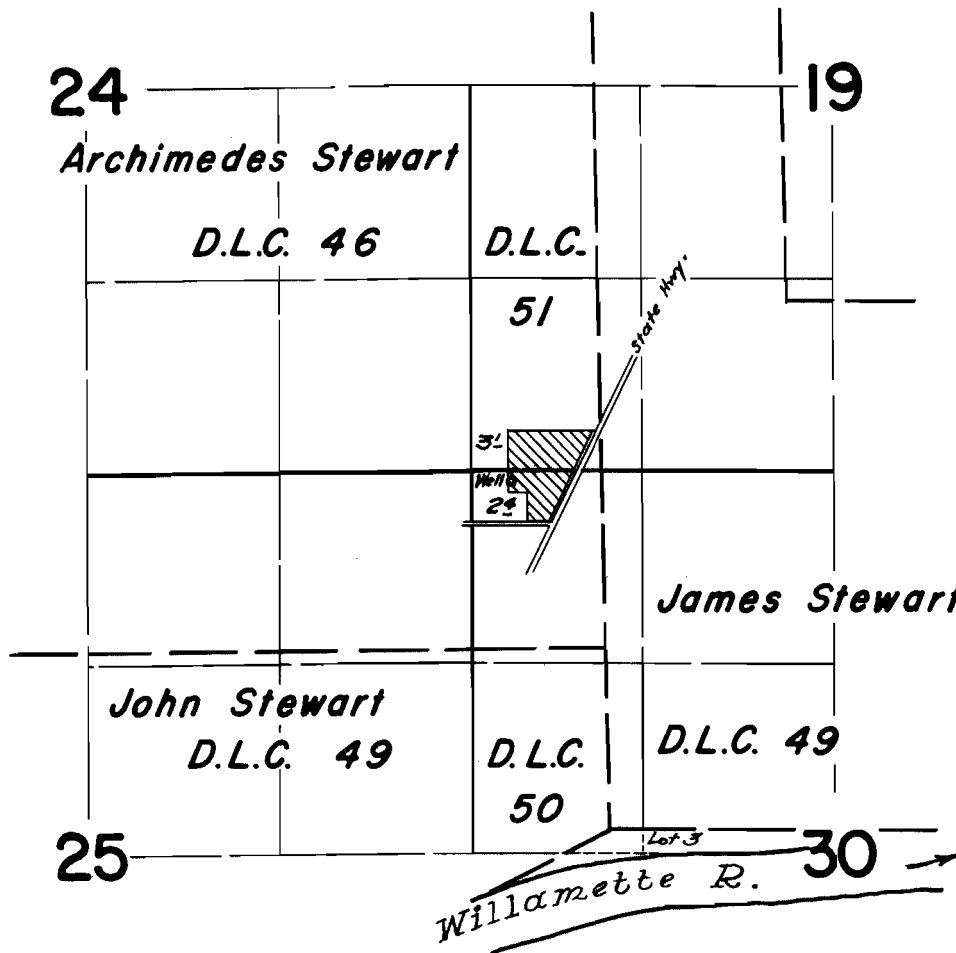

FINAL PROOF SURVEY UNDER

Application No. G-2613. Permit No. G-2425
IN NAME OF

HOMER F. & ALFREDA R. TWEDT

Surveyed Nov. 13, 1963, by *Al Peterson*