


T.12 S. R. 5 W. W. M.

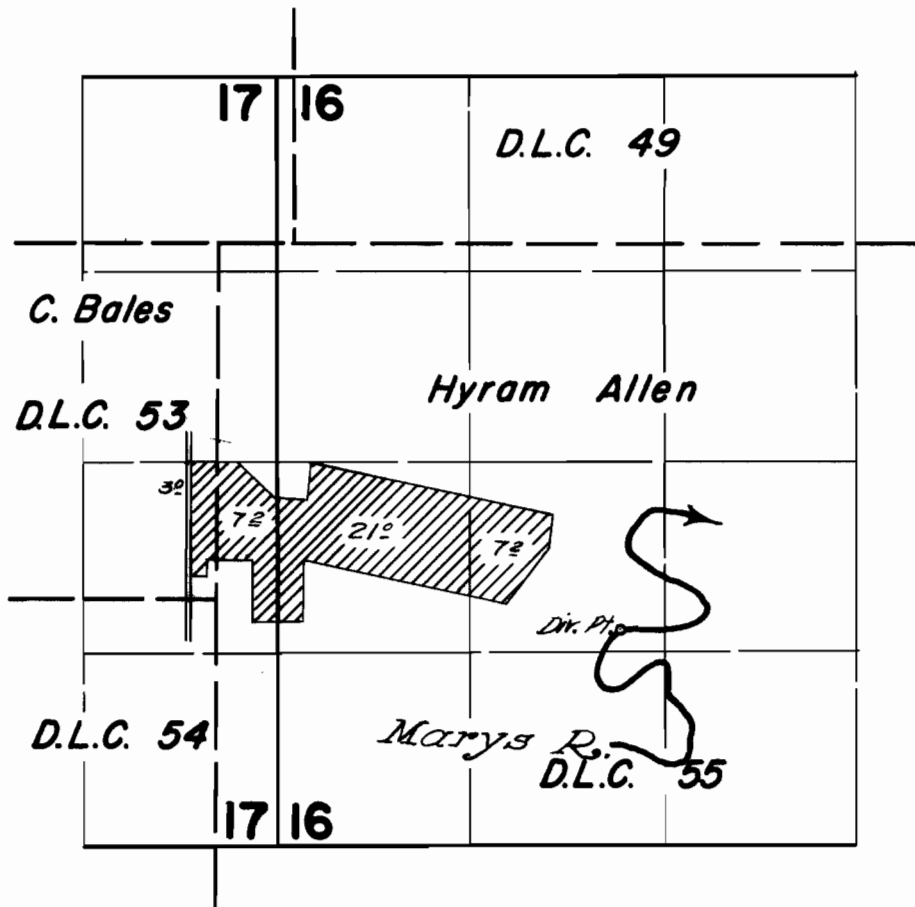

**FINAL PROOF SURVEY**  
UNDER

Application No. 38817... Permit No. 28887...  
IN NAME OF

HOWARD L. CROFF

Surveyed Nov. 14 1903, by