


T.11S.R.4W.W.M.

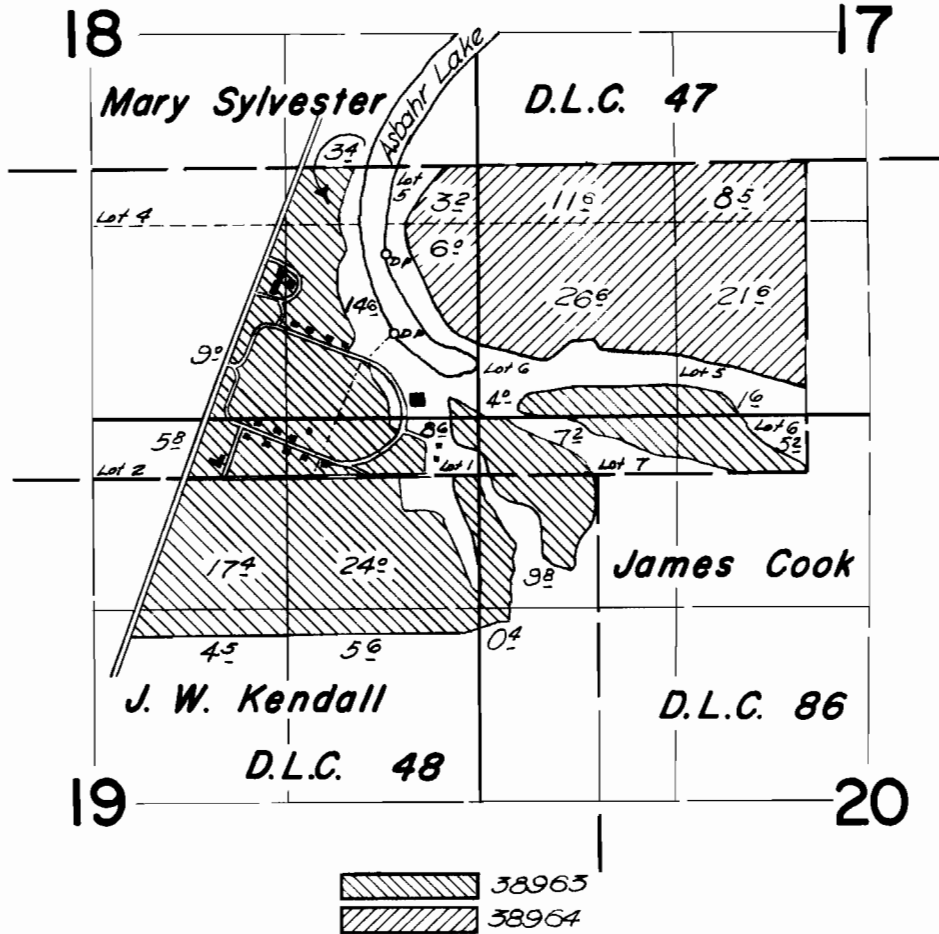

FINAL PROOF SURVEY UNDER

Application No. **38963** Permit No. **28910**
~~38964~~ **38964** Permit No. ~~28911~~ **28911**
IN NAME OF

CHILDREN'S FARM HOME

Surveyed Nov. 14, 1963, by *R. J. Johnson*