


# T.II S. R. 4 W. W. M.

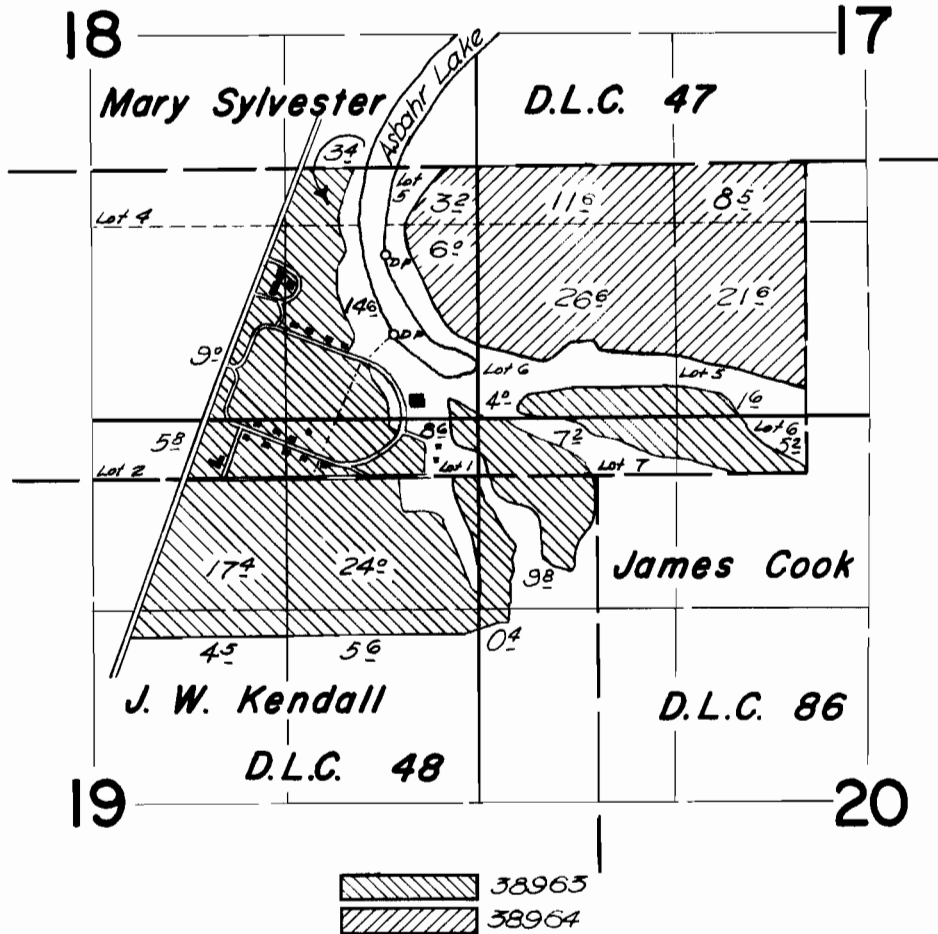

## FINAL PROOF SURVEY UNDER

Application No. **38963** ... Permit No. **28910**  
~~38964~~ ... ~~28911~~  
 IN NAME OF

**CHILDREN'S FARM HOME**

Surveyed *Nov. 14*, 1963, by *R. J. [Signature]*