


T.3S.R.1E.W.M.

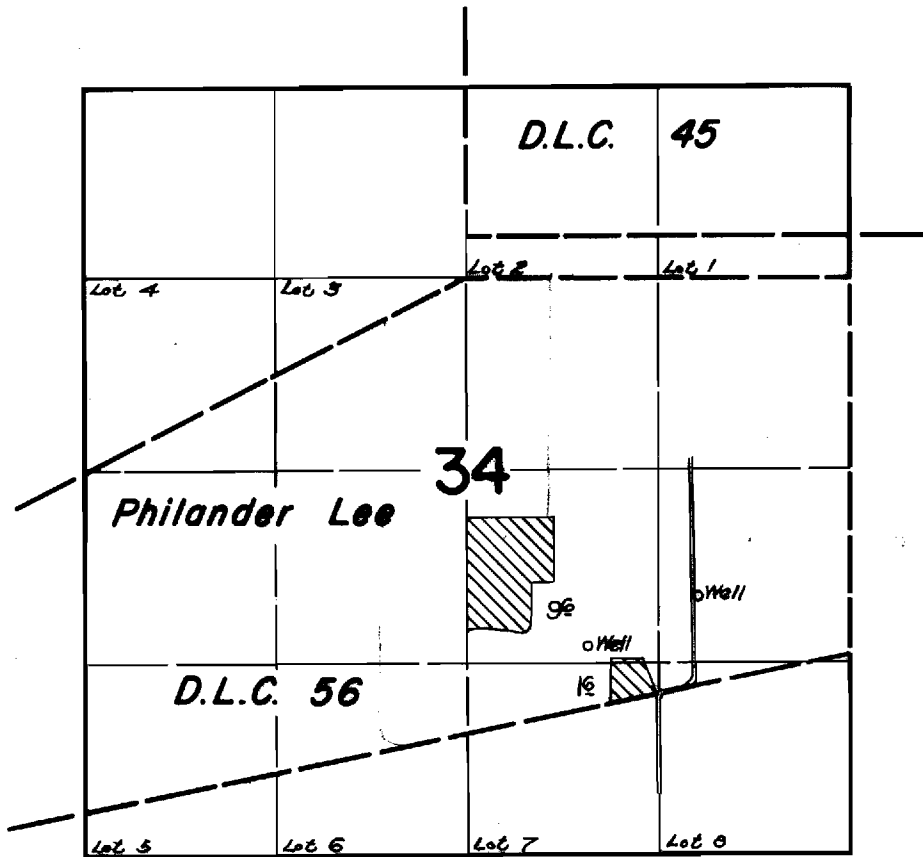

FINAL PROOF SURVEY UNDER

Application No. G-1639 Permit No. G-1499
IN NAME OF

EMIL P. KRAFT

Surveyed April 24, 1963, by