


T.24S.R.12^WW.M.

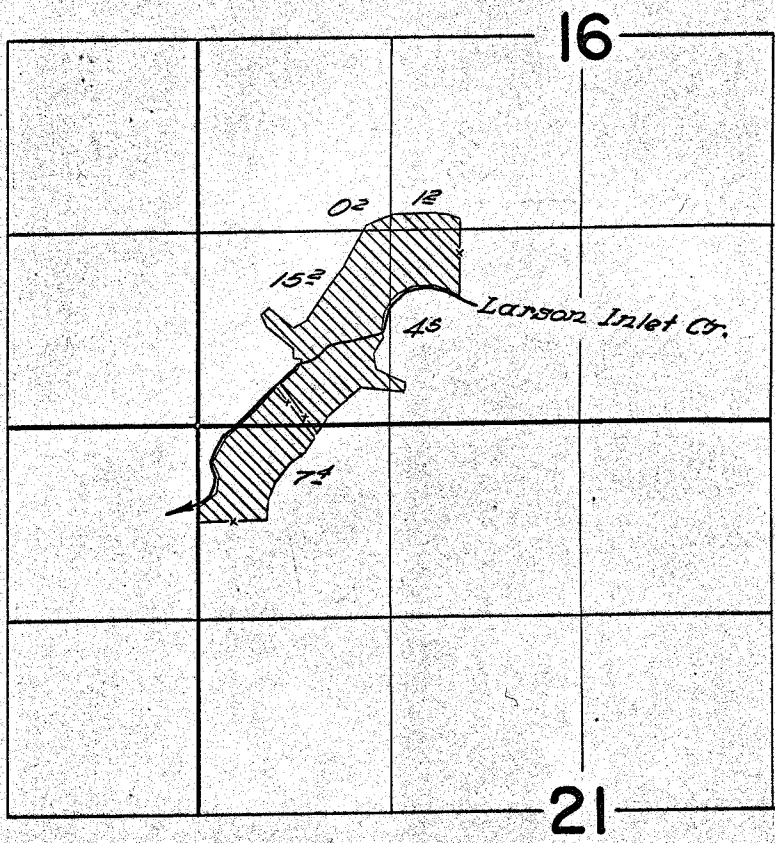

FINAL PROOF SURVEY
UNDER

Application No. 32361... Permit No. 25763...
IN NAME OF

GROSSEN BROS.

Surveyed August 12 1963, by *R. H. Johnson*