


T.24&25S.R.13W.W.M.

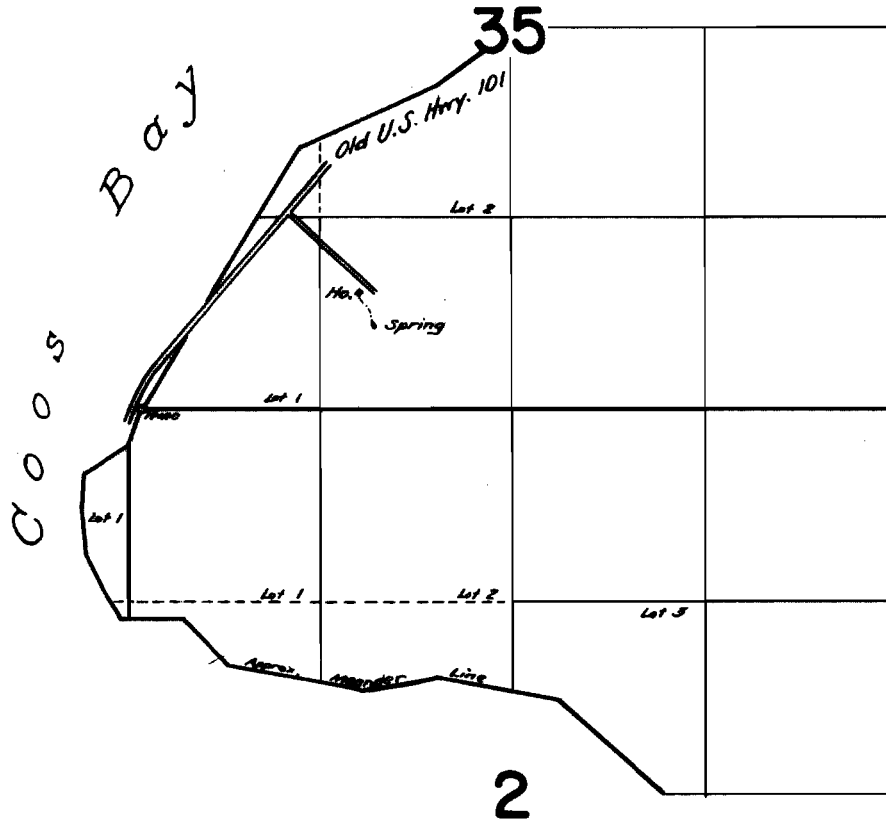

**FINAL PROOF SURVEY**  
UNDER

Application No. 33090... Permit No. 26327...  
IN NAME OF

..... NOBLE V. HANKINS .....

Surveyed August 14, 1963, by *R. Jackson*