


T.25 S. R.13 W. W.M.

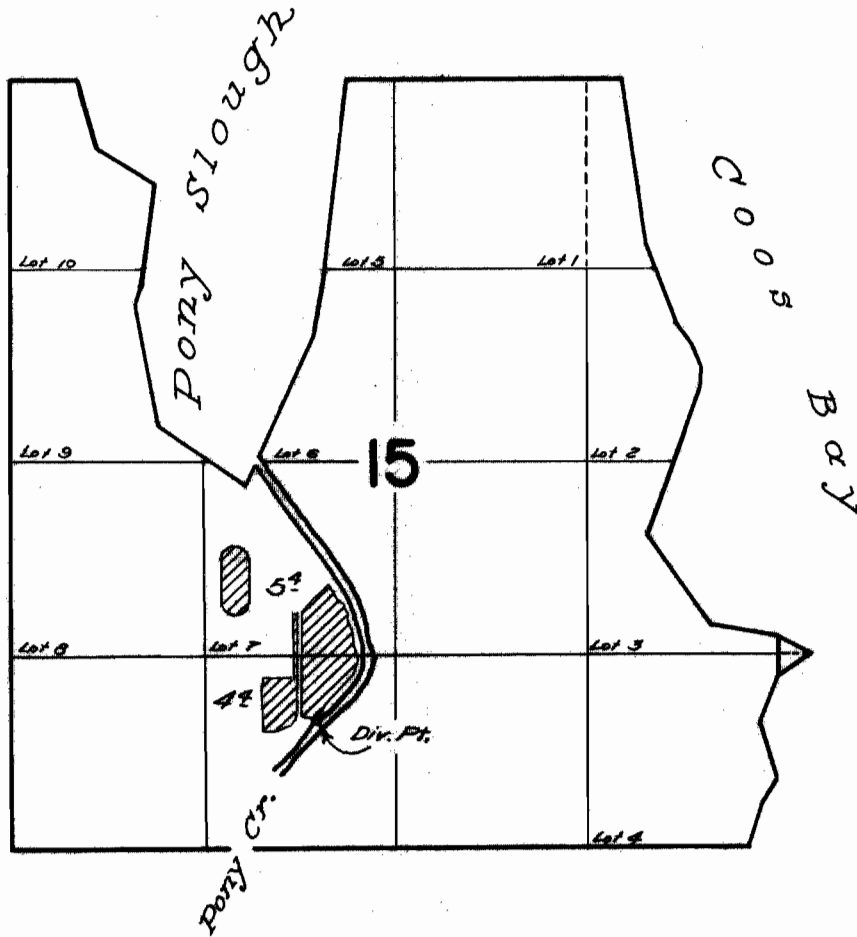

**FINAL PROOF SURVEY**  
UNDER

Application No. 34022. Permit No. 26832...  
IN NAME OF

SCHOOL DISTRICT 13

Surveyed August 8, 1963, by *R. Jackson*