


# T.24&25S.R.IIW.W.M.

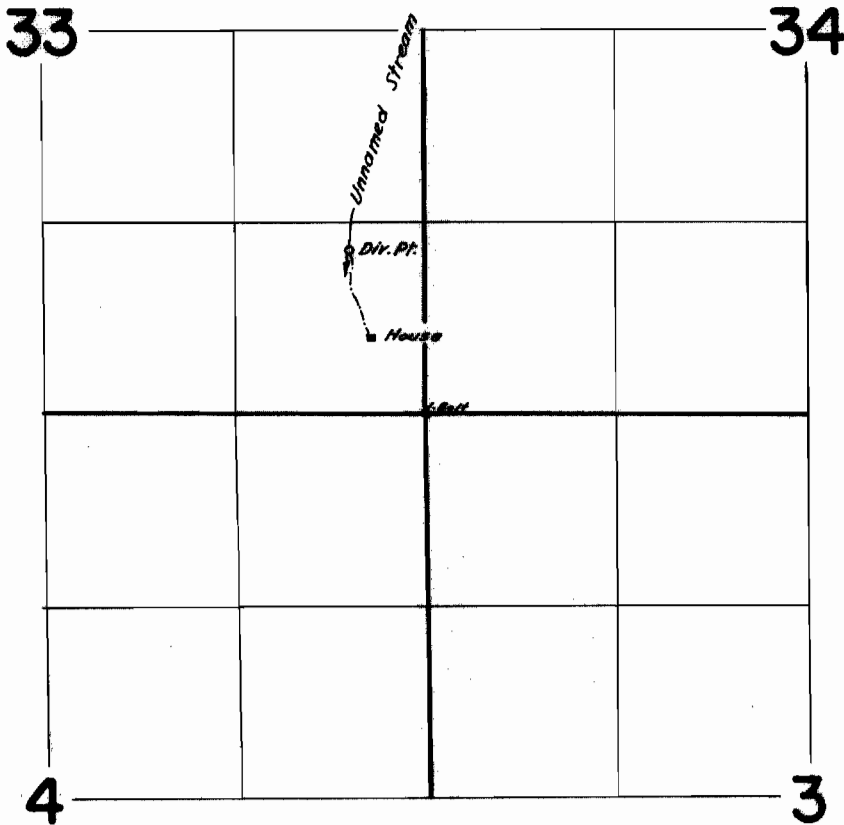

## FINAL PROOF SURVEY UNDER

Application No. 34480 Permit No. 27078  
IN NAME OF

CHARLES GERALD KROEGER

Surveyed August 9 1963, by Alpekson