


T.25S.R.12W.W.M.

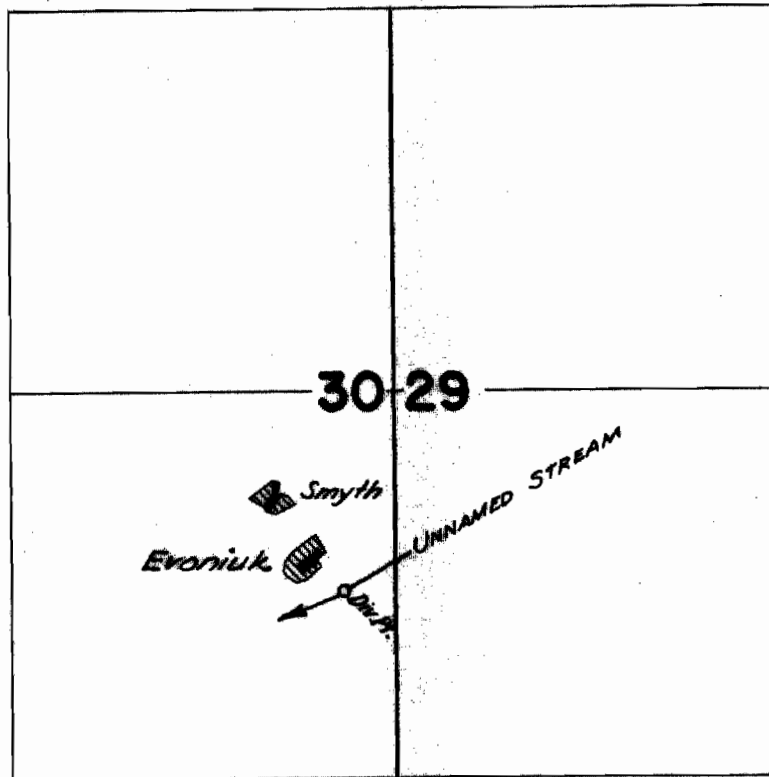

Scale: 1" = 660'

FINAL PROOF SURVEY
UNDER

Application No. 37076 Permit No. 27580

IN NAME OF
LOUIE & CECELIA E. EVONIUK
A. V. SMYTH

Surveyed August 9, 1963, by