


T.26S.R.13W.W.M.

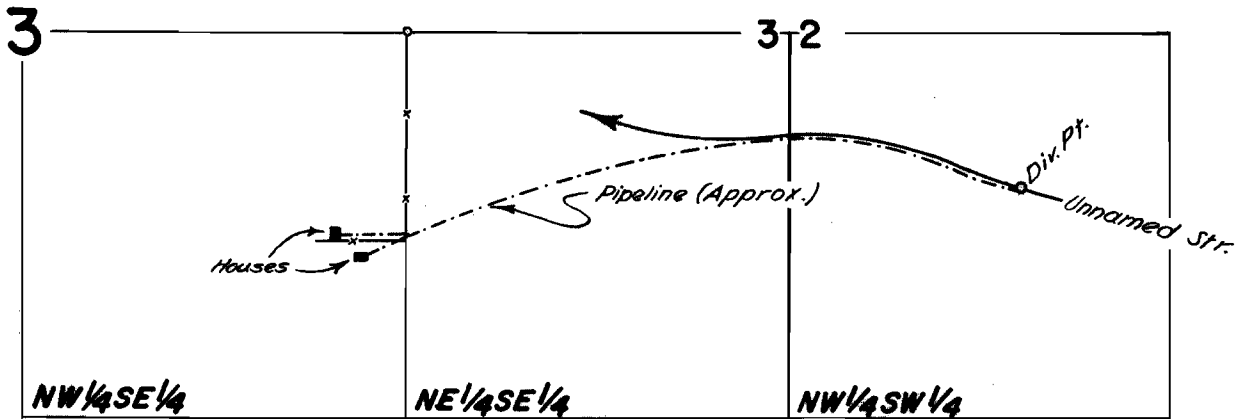

Scale: 1" = 660'

FINAL PROOF SURVEY UNDER

Application No. 37223 Permit No. 27740
IN NAME OF

ALVA E. STOVALL

Surveyed August 13 1963, by *Alphason*