


T.26S.R.12W.W.M.

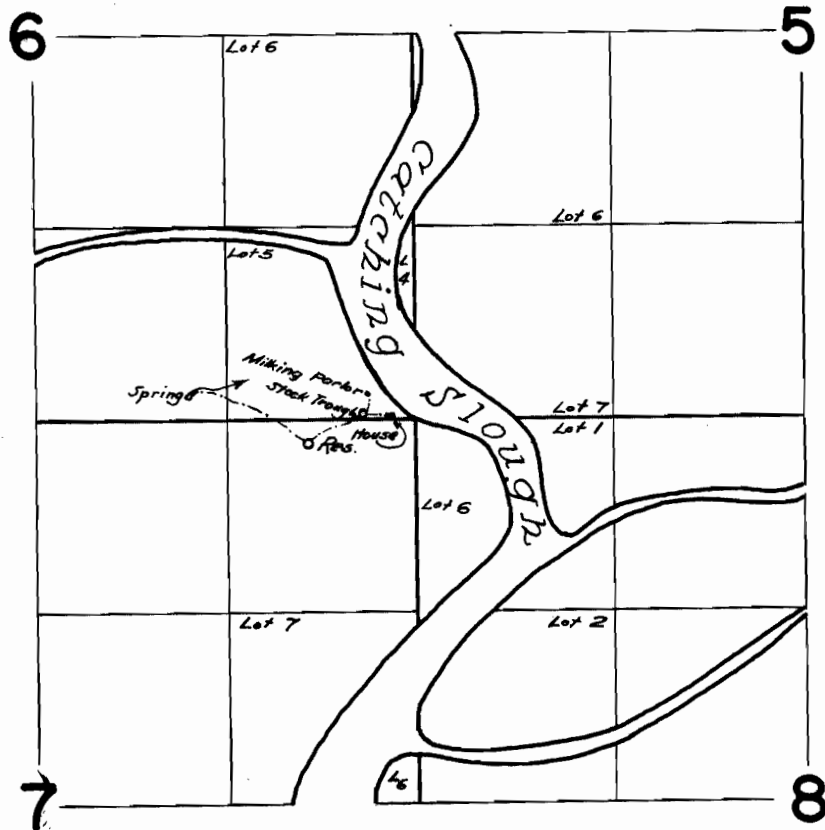

FINAL PROOF SURVEY
UNDER

Application No. 37866 Permit No. 28363
IN NAME OF

OLIN THOMAS & LORRAINE V. JENKINS

Surveyed August 10 1963, by A Jackson