


T.26S.R.12W.W.M.

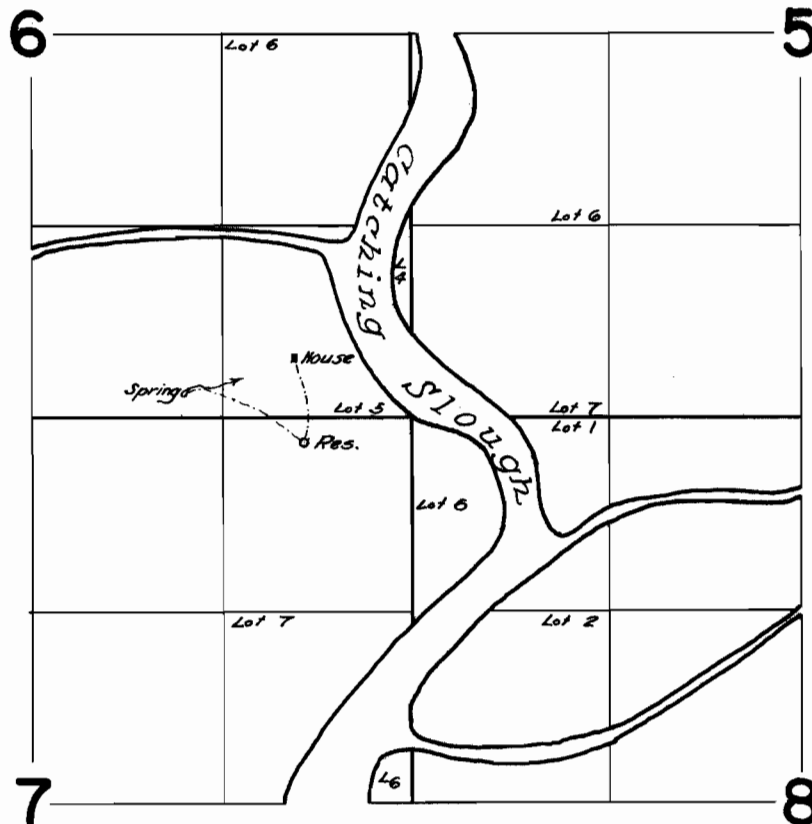

**FINAL PROOF SURVEY**  
UNDER

Application No. 37867... Permit No. 28364...  
IN NAME OF

ALF. M. NELSON

Surveyed August 10 1963, by *R. Jackson*