


31563

T.14S. R.16E.WM

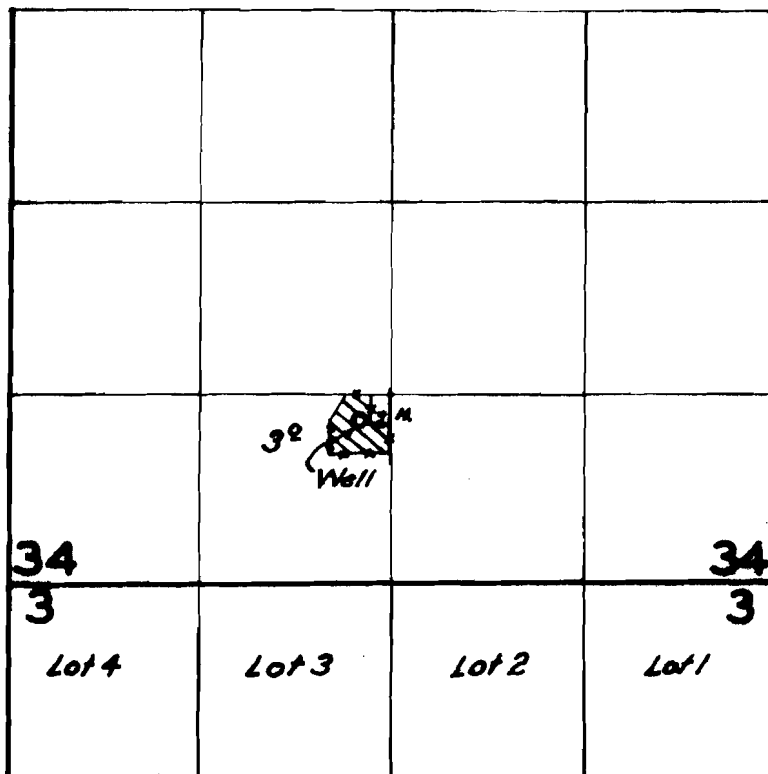

FINAL PROOF SURVEY UNDER

Application No. *G-1149* Permit No. *G-1101*
IN NAME OF

Robert G. O'Doherty

Surveyed *Oct. 29*, 1962, by *Carl R. Baker*

G-1101
1000-0