


T.30S.R.2W.W.M.

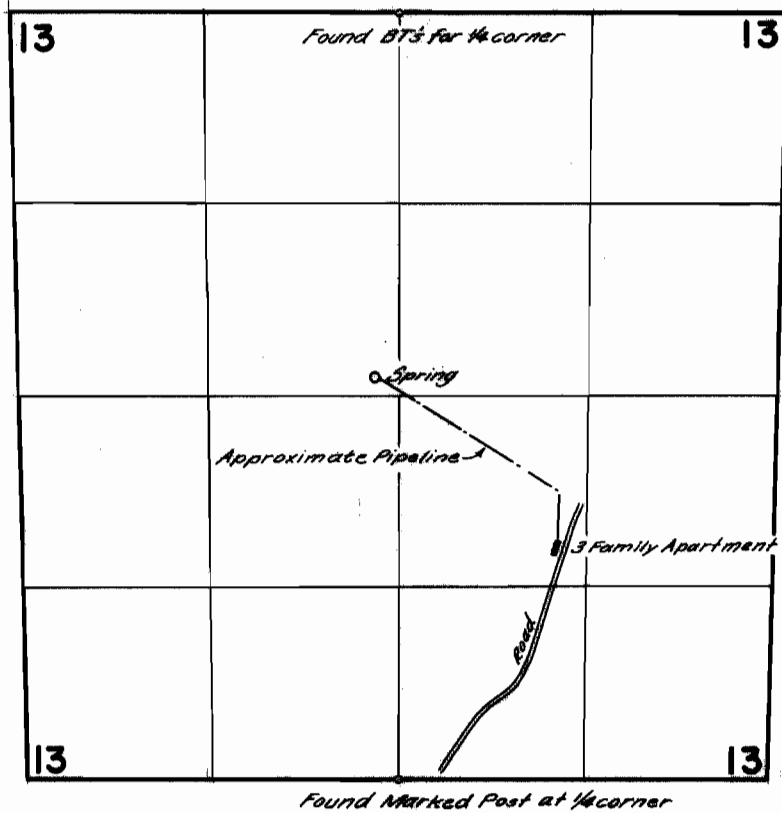

**FINAL PROOF SURVEY**  
UNDER

Application No. 34477 Permit No. 27077  
IN NAME OF

**U.S. Forest Service**

Surveyed May 21, 1963, by T. Lauer