


T.26S.R.33&34 E.W.M.

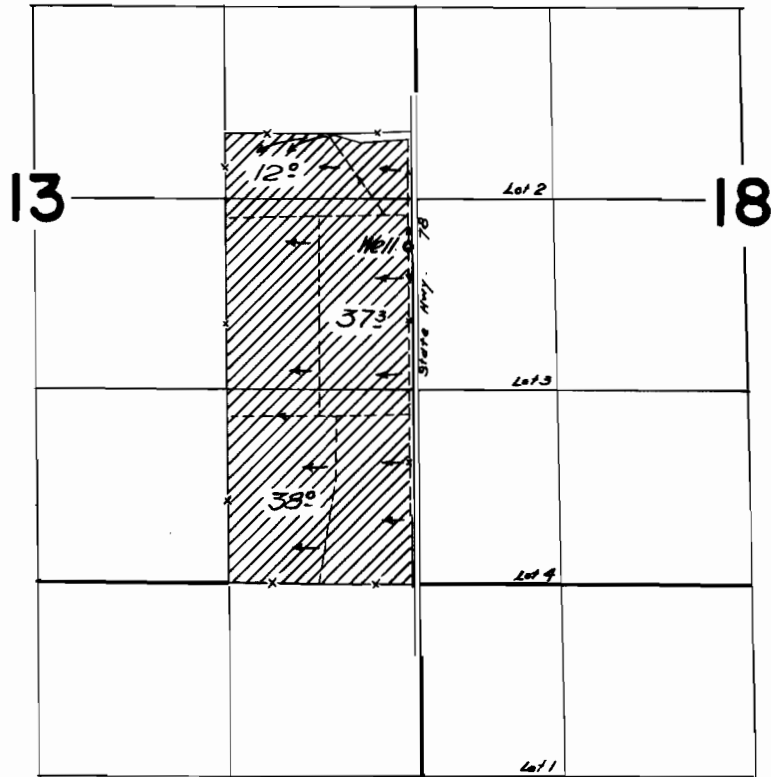

FINAL PROOF SURVEY UNDER

Application No. G-313 Permit No. G-408
IN NAME OF

LESTER THOMPSON

Surveyed Sept. 13 1963, by L. Thompson