


T.24S.R.30E.W.M.

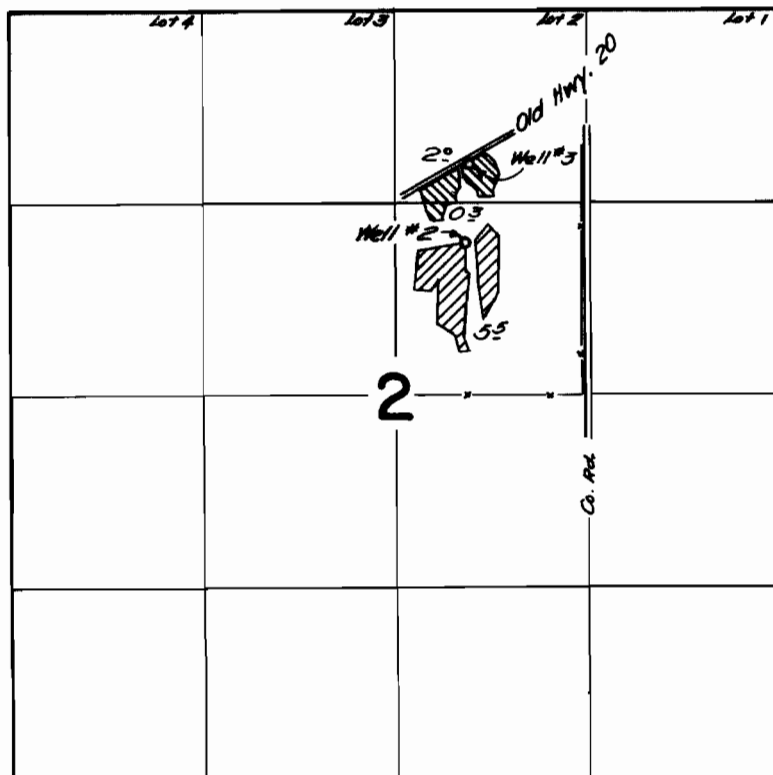

FINAL PROOF SURVEY
UNDER

Application No. G-1061 Permit No. G-977
IN NAME OF

Robt. K & Marjary A. Wood

Surveyed Sept. 16, 1903, by R. Jackson