


T.25S.R.34E.W.M.

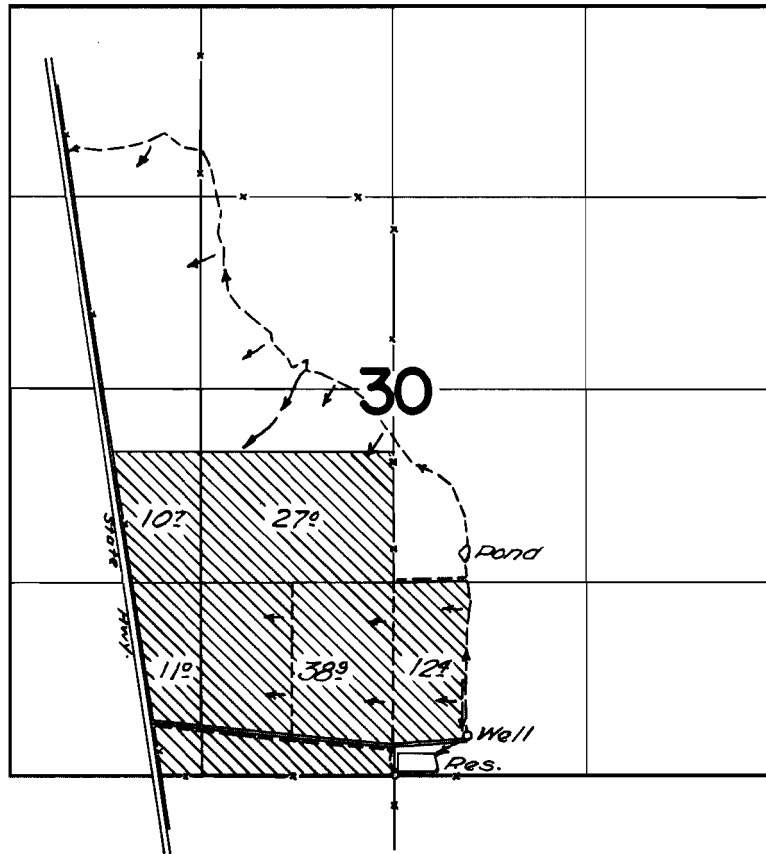

FINAL PROOF SURVEY
UNDER

Application No. 6-1357 Permit No. 6-1236
IN NAME OF

FORREST SKINNER

Surveyed Sept. 16 1963 by [Signature]