


T.25S.R.34E.W.M.

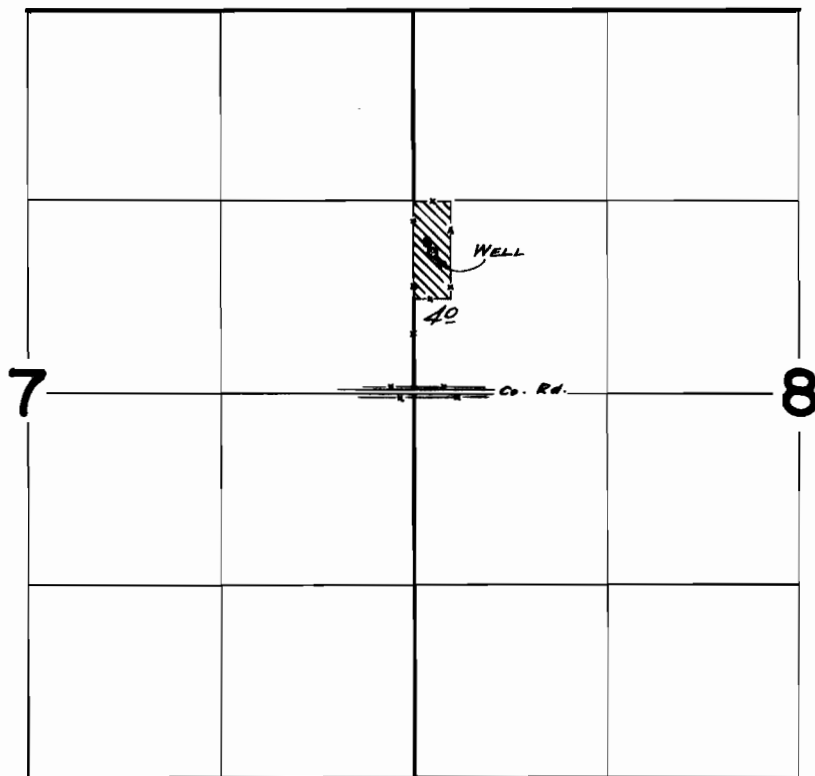

FINAL PROOF SURVEY
UNDER

Application No. G-1849 Permit No. G-1692
IN NAME OF

HENRY E. BLEULER

Surveyed Sept. 13, 1963, by

[Signature]