


T.39S.R.8W.W.M.

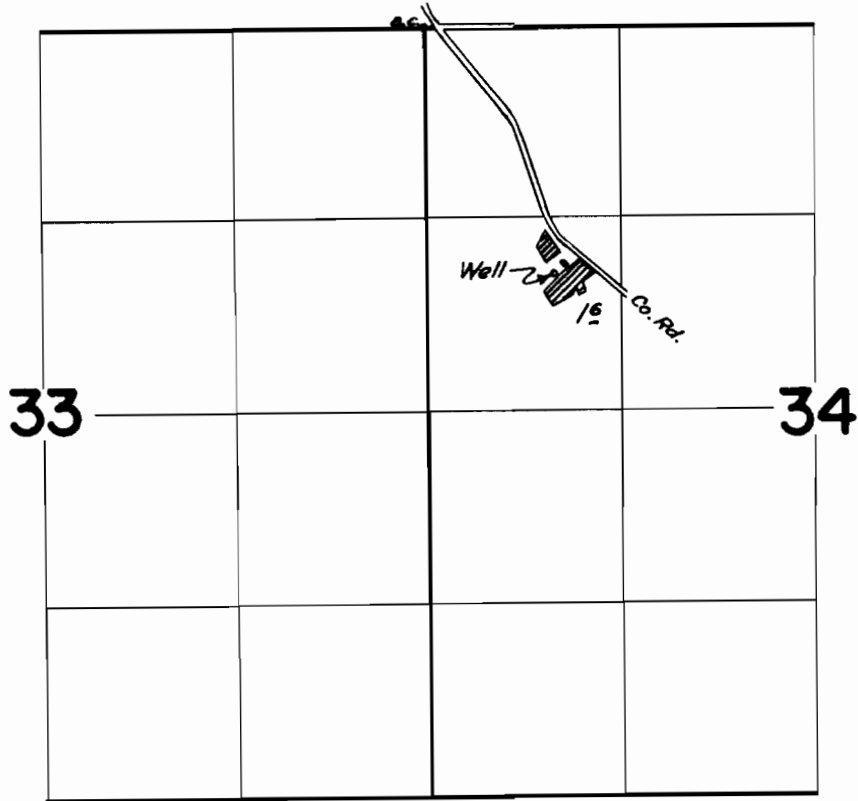

FINAL PROOF SURVEY
UNDER

Application No. G-1202.. Permit No. G-1061....
IN NAME OF

RUSSELL H. DAVIS

Surveyed June 12, 1963, by

R. Jackson