


TWP 37 S R6WWM

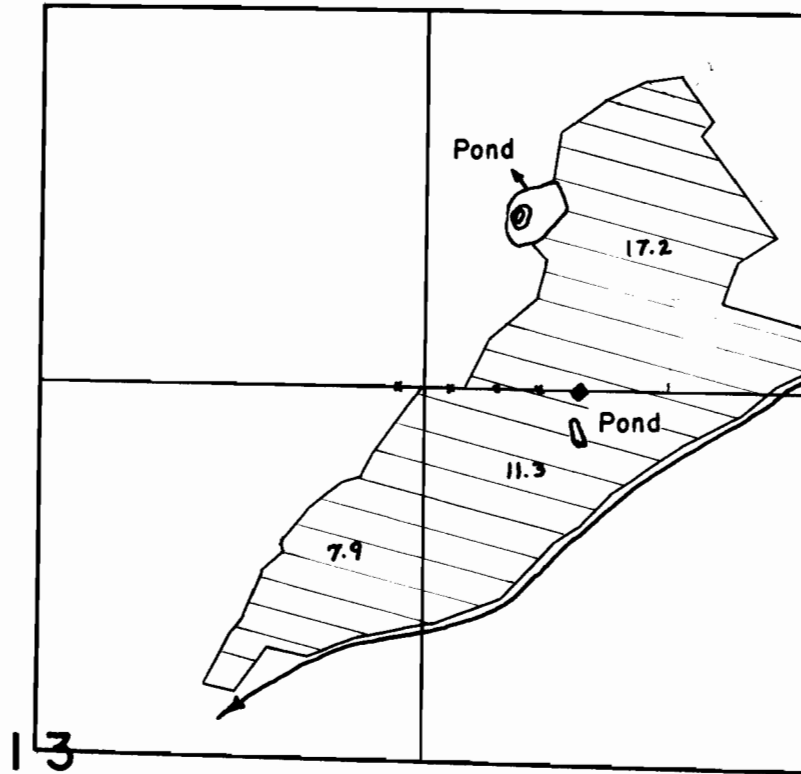

NE 1/4 SEC. 13

Scale 8" = 1 Mi

**FINAL PROOF SURVEY**  
UNDER

Application No. G-1776. Permit No. G-1624.  
IN NAME OF

.....Orie L. Boyer.....

Surveyed 6-6 1963., by R. Steimer.....