


# T.38S.R.5W.W.M.

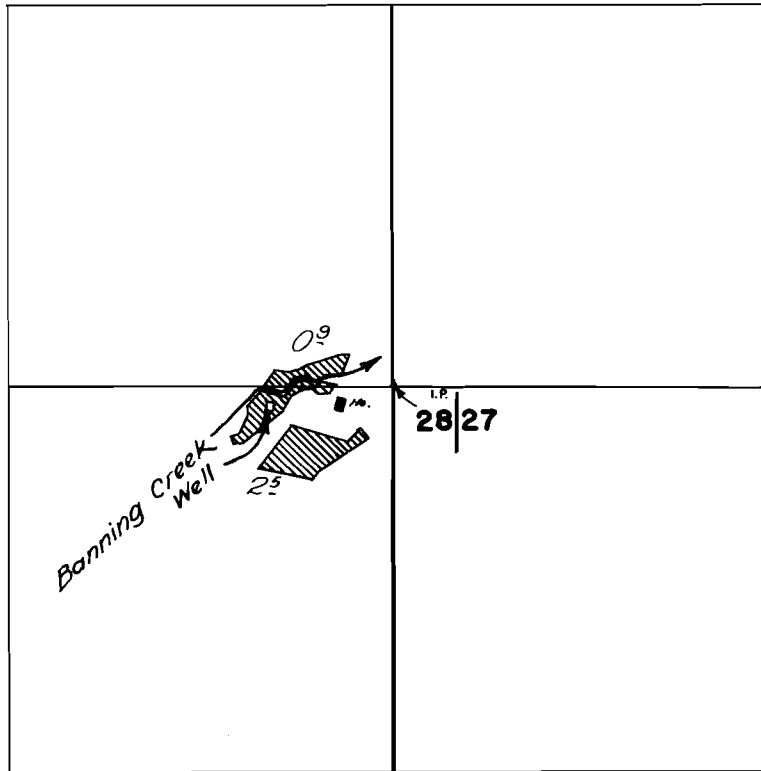

Scale : 1" = 660'

## FINAL PROOF SURVEY UNDER

Application No. G-2110 Permit No. G-1947  
IN NAME OF

A. D. GRAY

Surveyed July 16, 1963, by

*[Signature]*