


TWP 39 S R 8 W W M

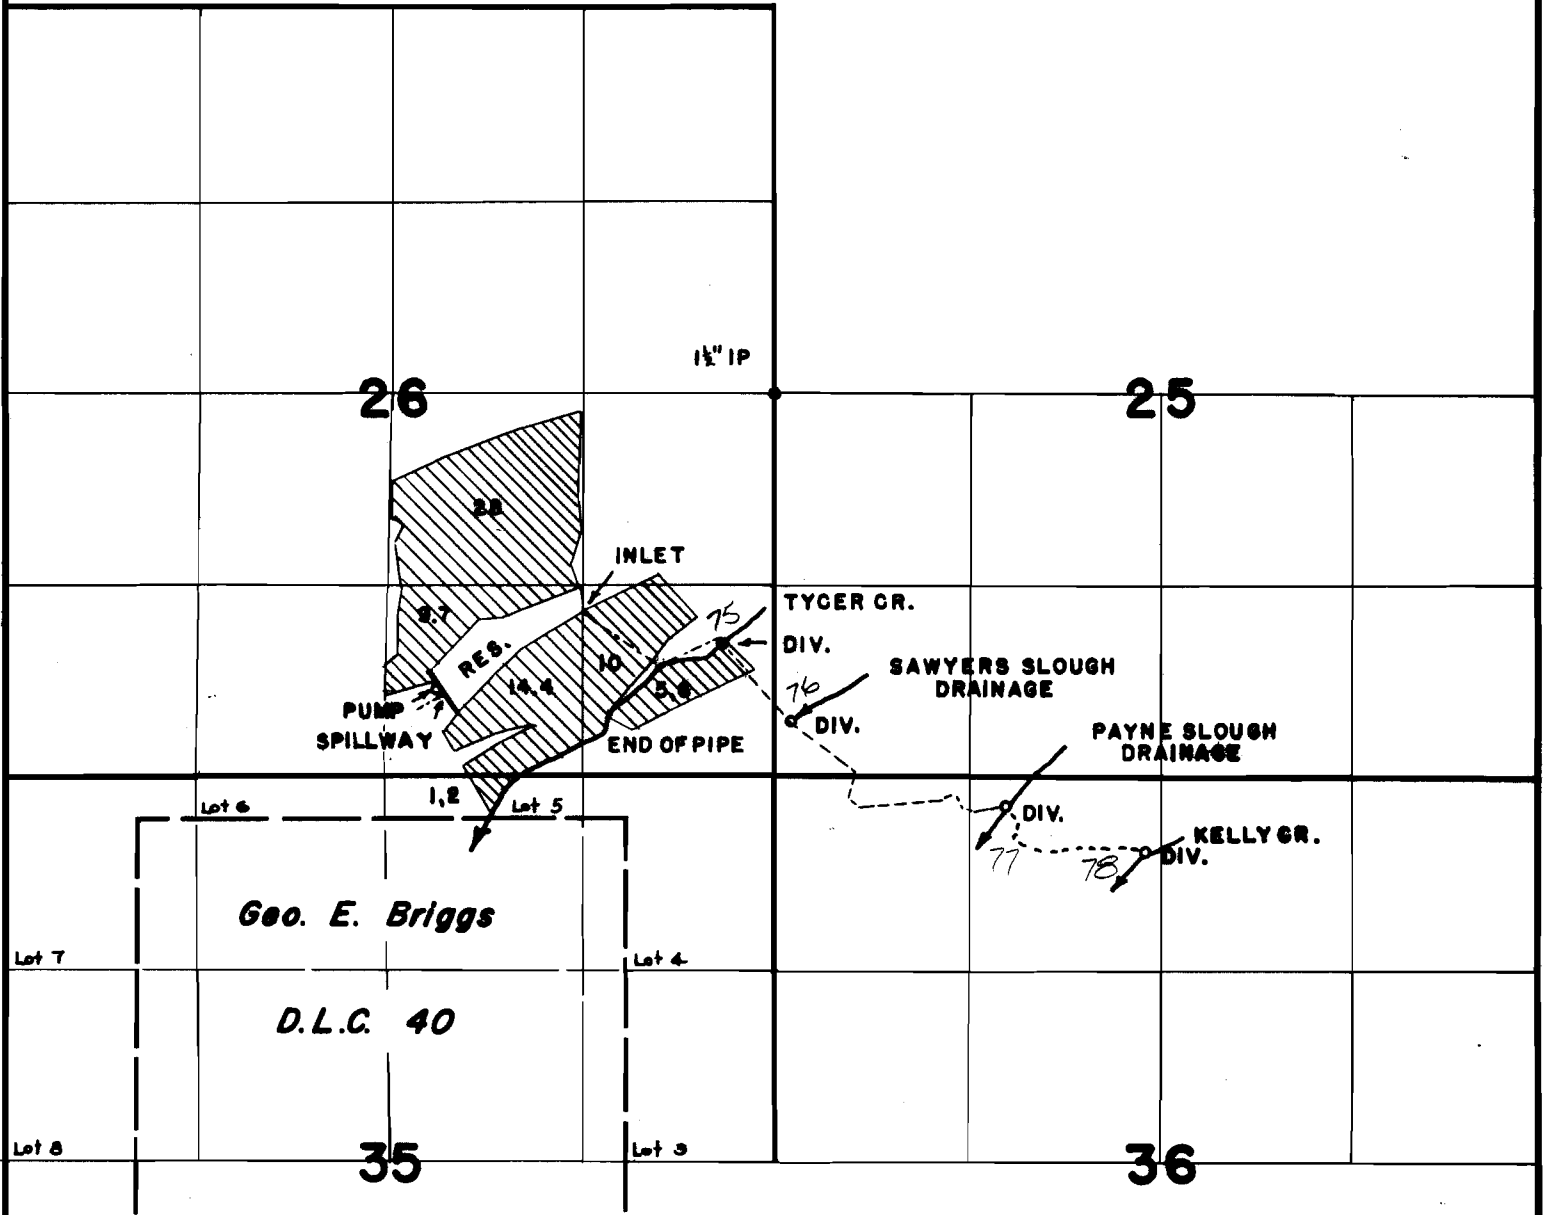

FINAL PROOF SURVEY
UNDER

R-30320 R-2118
Application No. 30321 Permit No. 25404
IN NAME OF

..... Edith L. Sewall

Surveyed 6-13 1962, by R Steimer