


T.39S.R.8 W.W.M.

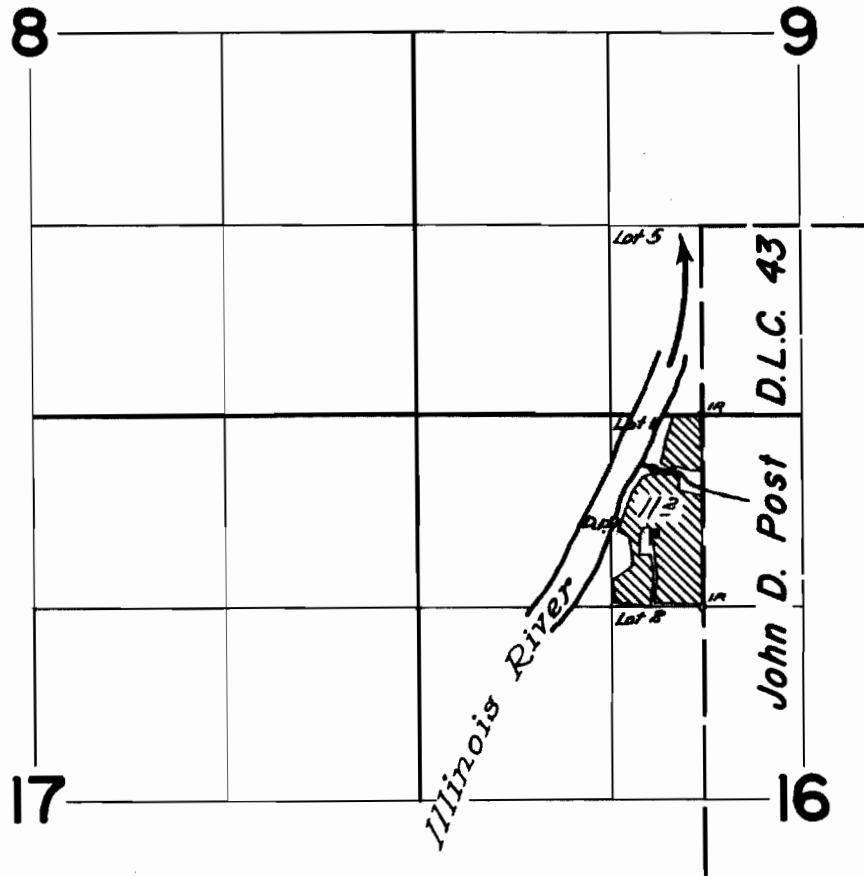

**FINAL PROOF SURVEY**  
UNDER

Application No. 33345.. Permit No. 28388..  
IN NAME OF

..... R. W. FINCHER .....

Surveyed June 7, 1963, by *R. Jackson*