


TWP. 33 S. R 7WWM

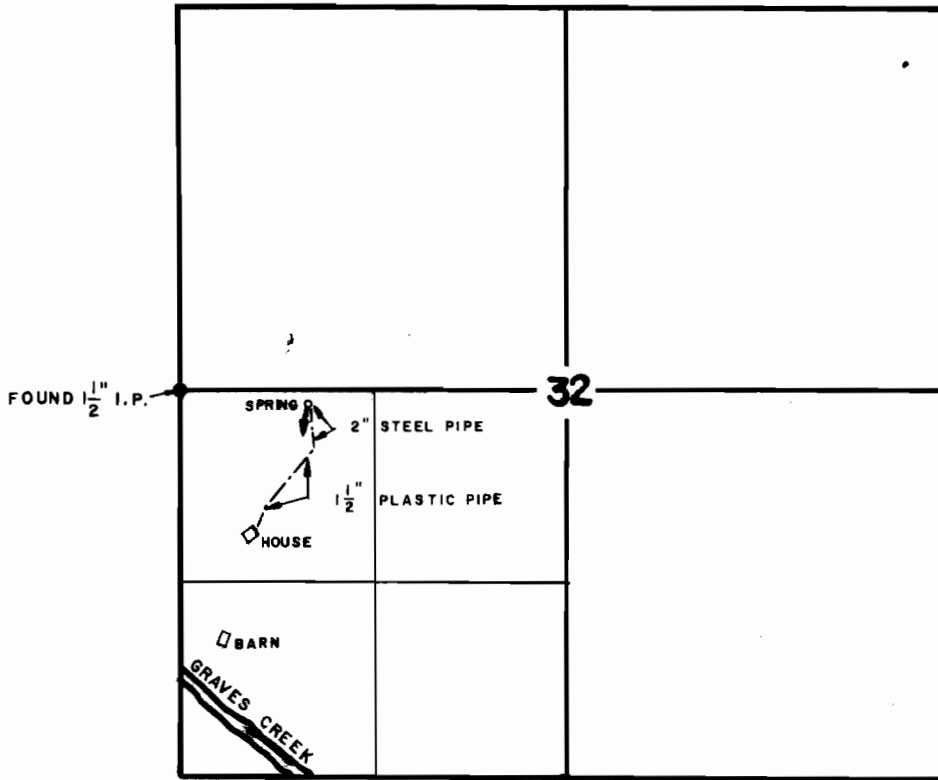

FINAL PROOF SURVEY UNDER

SCALE : 4" = 1 MILE

Application No. 33370 Permit No. 26378
IN NAME OF

CLAUDE E. And LAVINIA A. MOORE

Surveyed 6-14 1963, by R. STEIMER