


T.38S.R.5W.W.M.

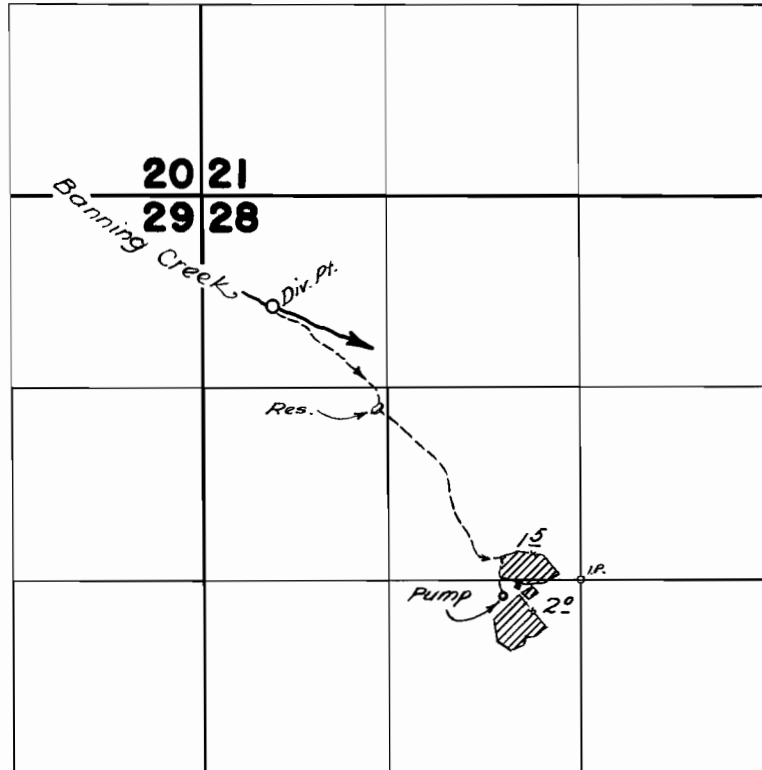

FINAL PROOF SURVEY UNDER

Application No. **33594** ... Permit No. **26612** ...
IN NAME OF

WILLIAM L. BLUMENFELD

Surveyed *June 13*, 1963, by *Atkinson*